




1 SITE PLAN  
1:750


LEGEND	
	HYDRANT
	GAS SHUT-OFF

KITCHENER ELEMENTARY  
1351 S GILMORE AVENUE  
FACILITIES - RECORD DRAWING  
APRIL 2020

	BOARD OF EDUCATION	F 1.1
	<b>BURNABY</b> SCHOOL DISTRICT 41	

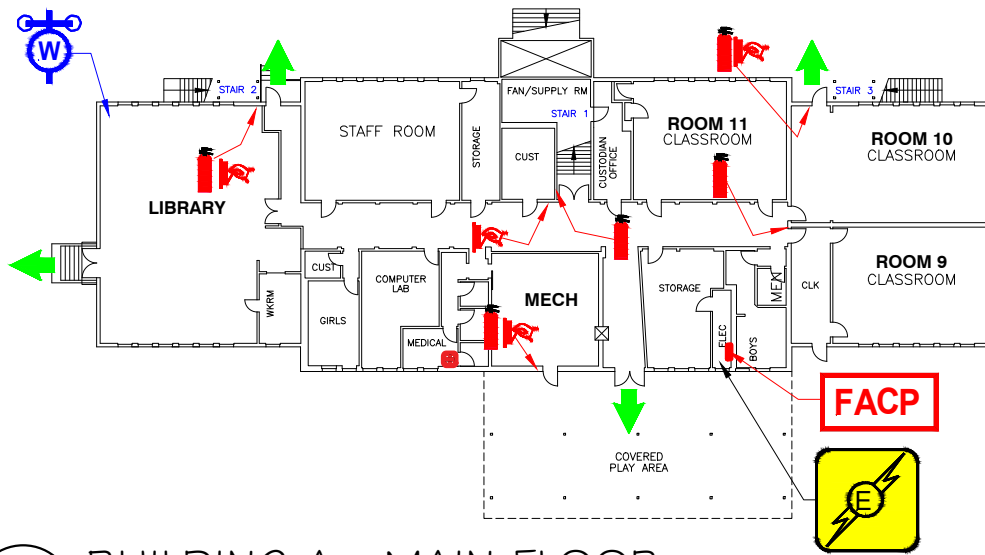

1 BUILDING A - MAIN FLOOR  
1:400

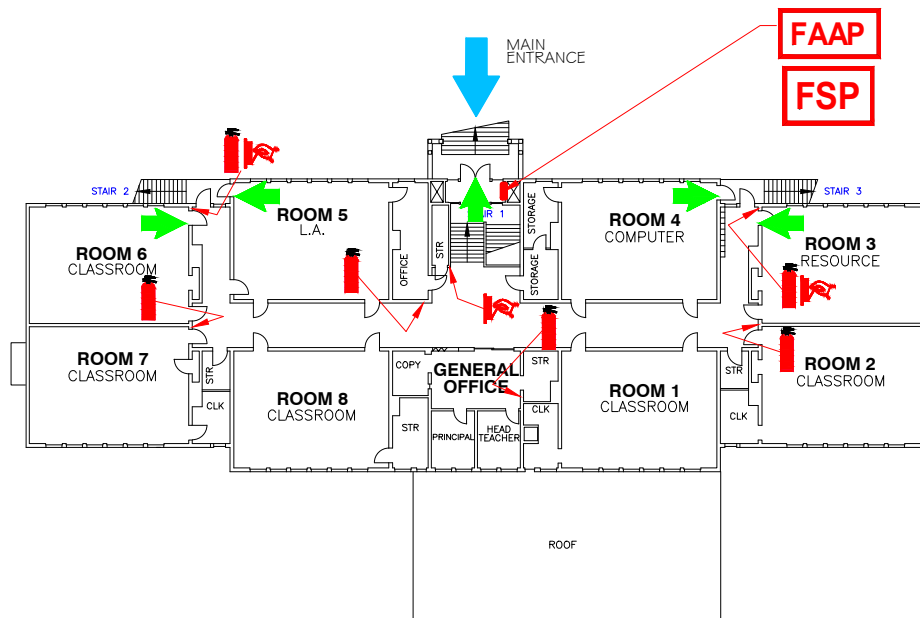



2 BUILDING A - SECOND FLOOR  
1:400

LEGEND		
	FIRE EXIT	
	DOMESTIC WATER SHUT-OFF	
	FIRE PULL STATION	
	FIRE ALARM CONTROL PANEL	
	FIRE ALARM CONTROL PANEL	
	FIRE SAFETY PLAN	

KITCHENER ELEMENTARY  
13515 GILMORE AVENUE  
FACILITIES - RECORD DRAWING  
APRIL 2020

**LEGEND**


	FIRE EXIT		FIRE EXTINGUISHER		FIRE ALARM ANNUNCIATOR
	DOMESTIC WATER SHUT-OFF		FIRE PULL STATION		FIRE ALARM CONTROL PANEL
	SPRINKLER SHUT-OFF		ELECTRICAL VAULT		FIRE SAFETY PLAN
			FIRE WALL / FIRE DOORS		

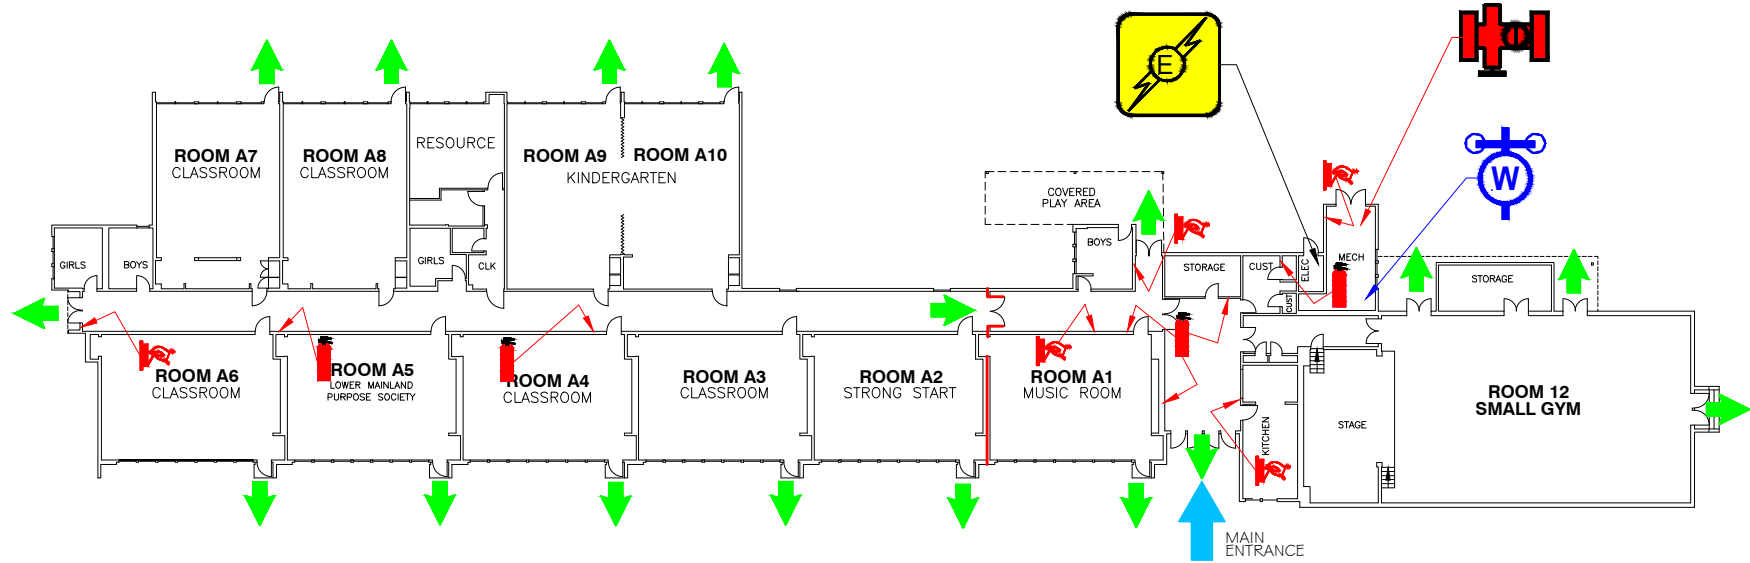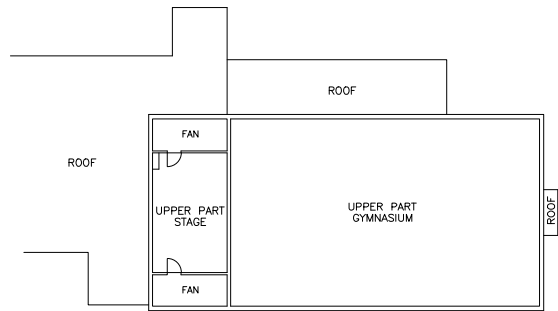


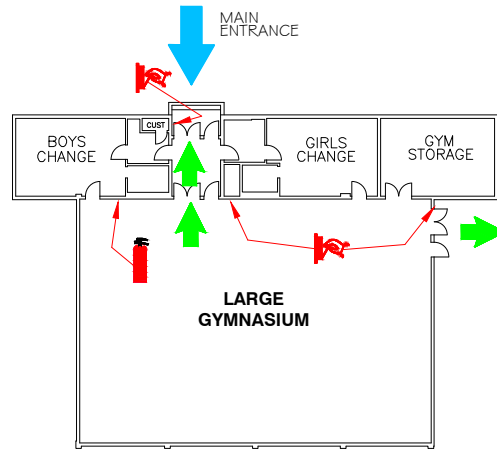
**BUILDING B - MAIN FLOOR**

1:400


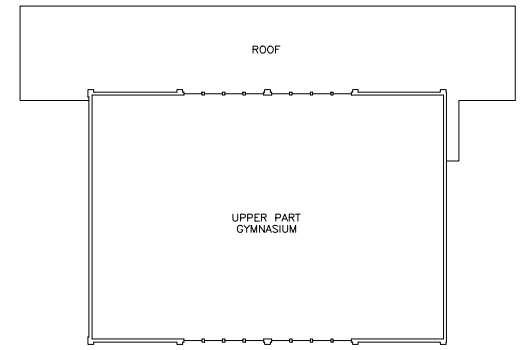
KITCHENER ELEMENTARY  
 13515 GILMORE AVENUE  
 FACILITIES - RECORD DRAWING  
 APRIL 2020

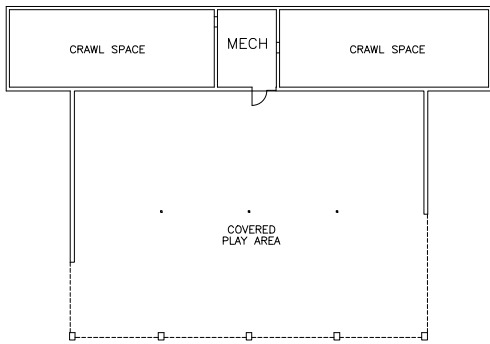


1 BUILDING C - BASEMENT  
1:400















2 BUILDING C - MAIN FLOOR  
1:400

3 BUILDING C - ROOF PLAN  
1:400



LEGEND			
	FIRE EXIT		FIRE EXTINGUISHER
	DOMESTIC WATER SHUT-OFF		FIRE PULL STATION
	SPRINKLER SHUT-OFF		ELECTRICAL VAULT
	FAAP		FACP
	FIRE ALARM ANNUNCIATOR		FIRE SAFETY PLAN
	FIRE ALARM CONTROL PANEL		

KITCHENER ELEMENTARY  
1351 S GILMORE AVENUE

FACILITIES - RECORD DRAWING

APRIL 2020