




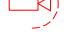
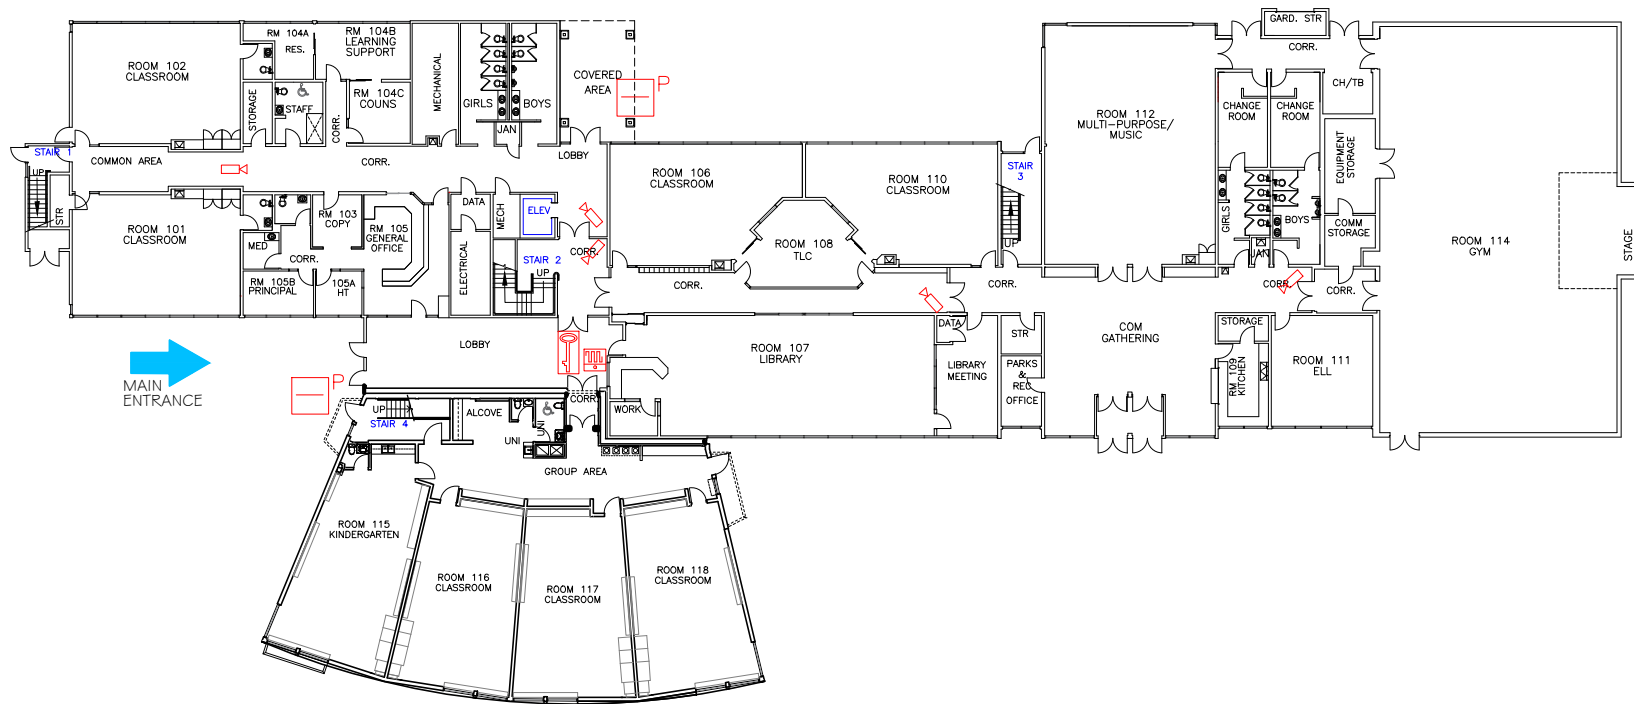



### SECURITY LEGEND

-  CARD ACCESS - PROXIMITY
-  SECURITY ALARM PANEL
-  KEY BOX
-  PUSH BUTTON
-  SECURITY CAMERA  
FIXED
-  SECURITY CAMERA  
PAN-TILT-ZOOM (PTZ)



1 MAIN FLOOR  
1:400



UNIVERSITY HIGHLANDS 9388 TOWER ROAD	
FACILITIES - RECORD DRAWING	
NOVEMBER 2020	
	<h1>E 2.2</h1> <h2>SECURITY</h2>