




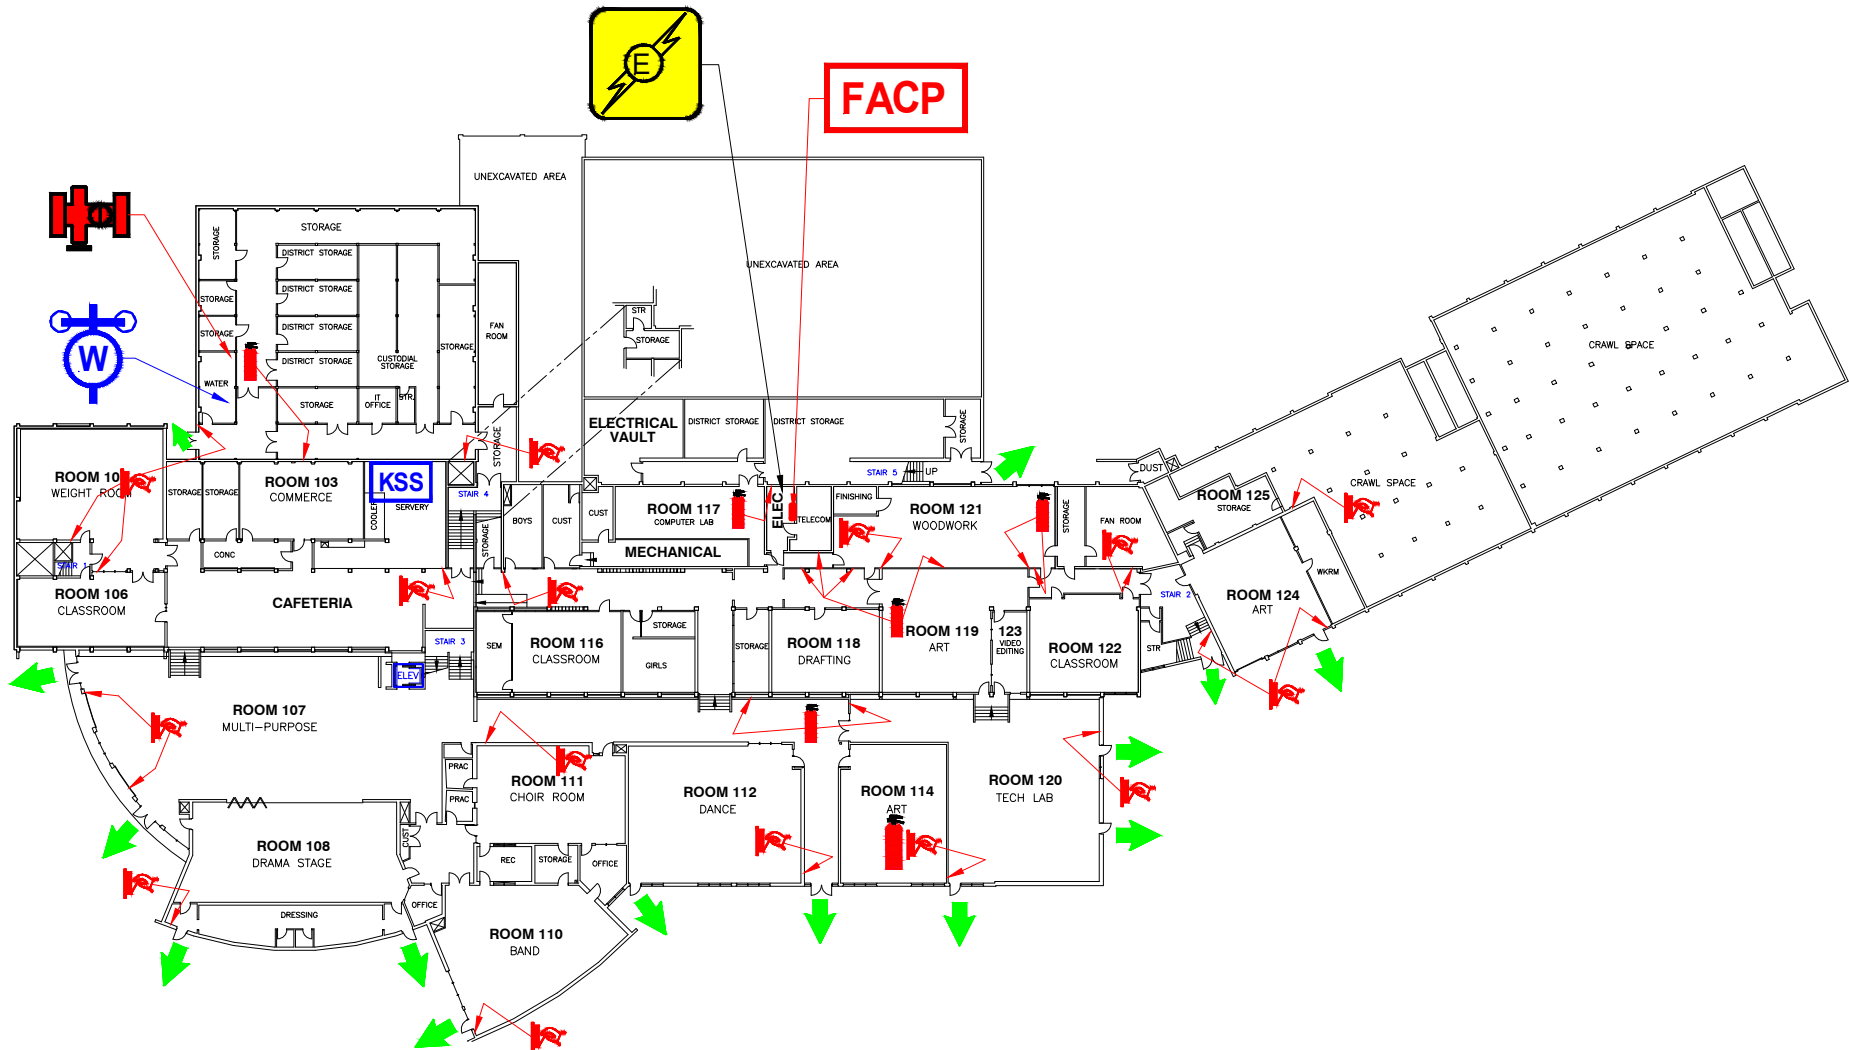


1 SITE PLAN
1:1000



LEGEND		
	HYDRANT	
	PRIVATE HYDRANT	
	FIRE DEPT. CONNECTION	
	GAS SHUT-OFF	

MOSCROP SECONDARY 4433 MOSCROP STREET	
FACILITIES - RECORD DRAWING	
JUNE 2020	
	F 1.1



1 MAIN FLOOR
1:500

LEGEND			
	FIRE EXIT		FIRE EXTINGUISHER
	DOMESTIC WATER SHUT-OFF		FIRE PULL STATION
	SPRINKLER SHUT-OFF		ELECTRICAL VAULT
	FAAP		FIRE ALARM ANNUNCIATOR
	FACP		FIRE ALARM CONTROL PANEL
	FSP		FIRE SAFETY PLAN


MOSCROP SECONDARY
4433 MOSCROP STREET

FACILITIES - RECORD DRAWING

JUNE 2020



F1.2

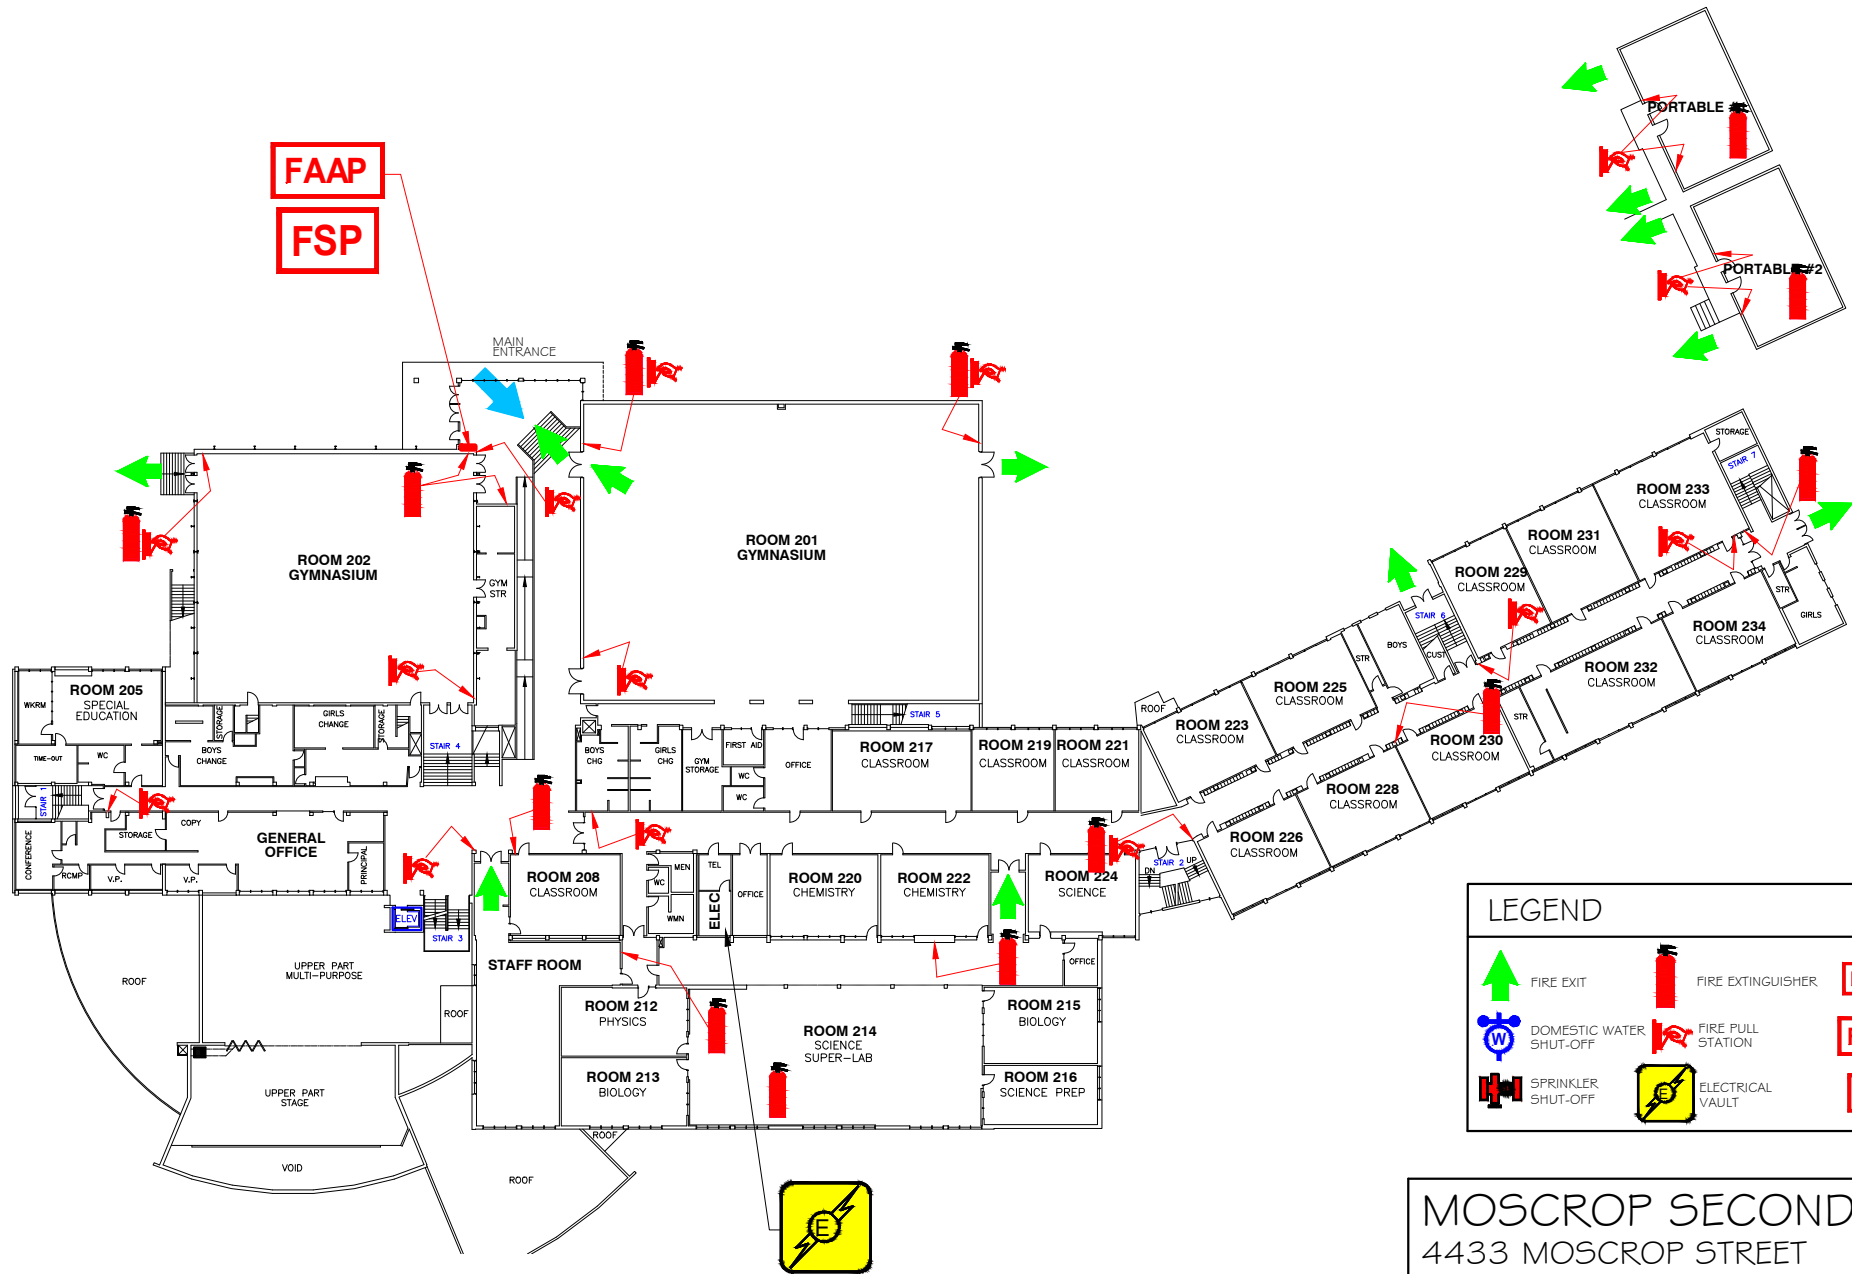

FAAP
FSP

LEGEND					
	FIRE EXIT		FIRE EXTINGUISHER		FIRE ALARM ANNUNCIATOR
	DOMESTIC WATER SHUT-OFF		FIRE PULL STATION		FIRE ALARM CONTROL PANEL
	SPRINKLER SHUT-OFF		ELECTRICAL VAULT		FIRE SAFETY PLAN










1 SECOND FLOOR
1:500


MOSCROP SECONDARY
4433 MOSCROP STREET
FACILITIES - RECORD DRAWING
JUNE 2020

BOARD OF EDUCATION
BURNABY
SCHOOL DISTRICT 41

F 1.3

LEGEND


	FIRE EXIT		FIRE EXTINGUISHER		FIRE ALARM ANNUNCIATOR
	DOMESTIC WATER SHUT-OFF		FIRE PULL STATION		FIRE ALARM CONTROL PANEL
	SPRINKLER SHUT-OFF		ELECTRICAL VAULT		FIRE SAFETY PLAN

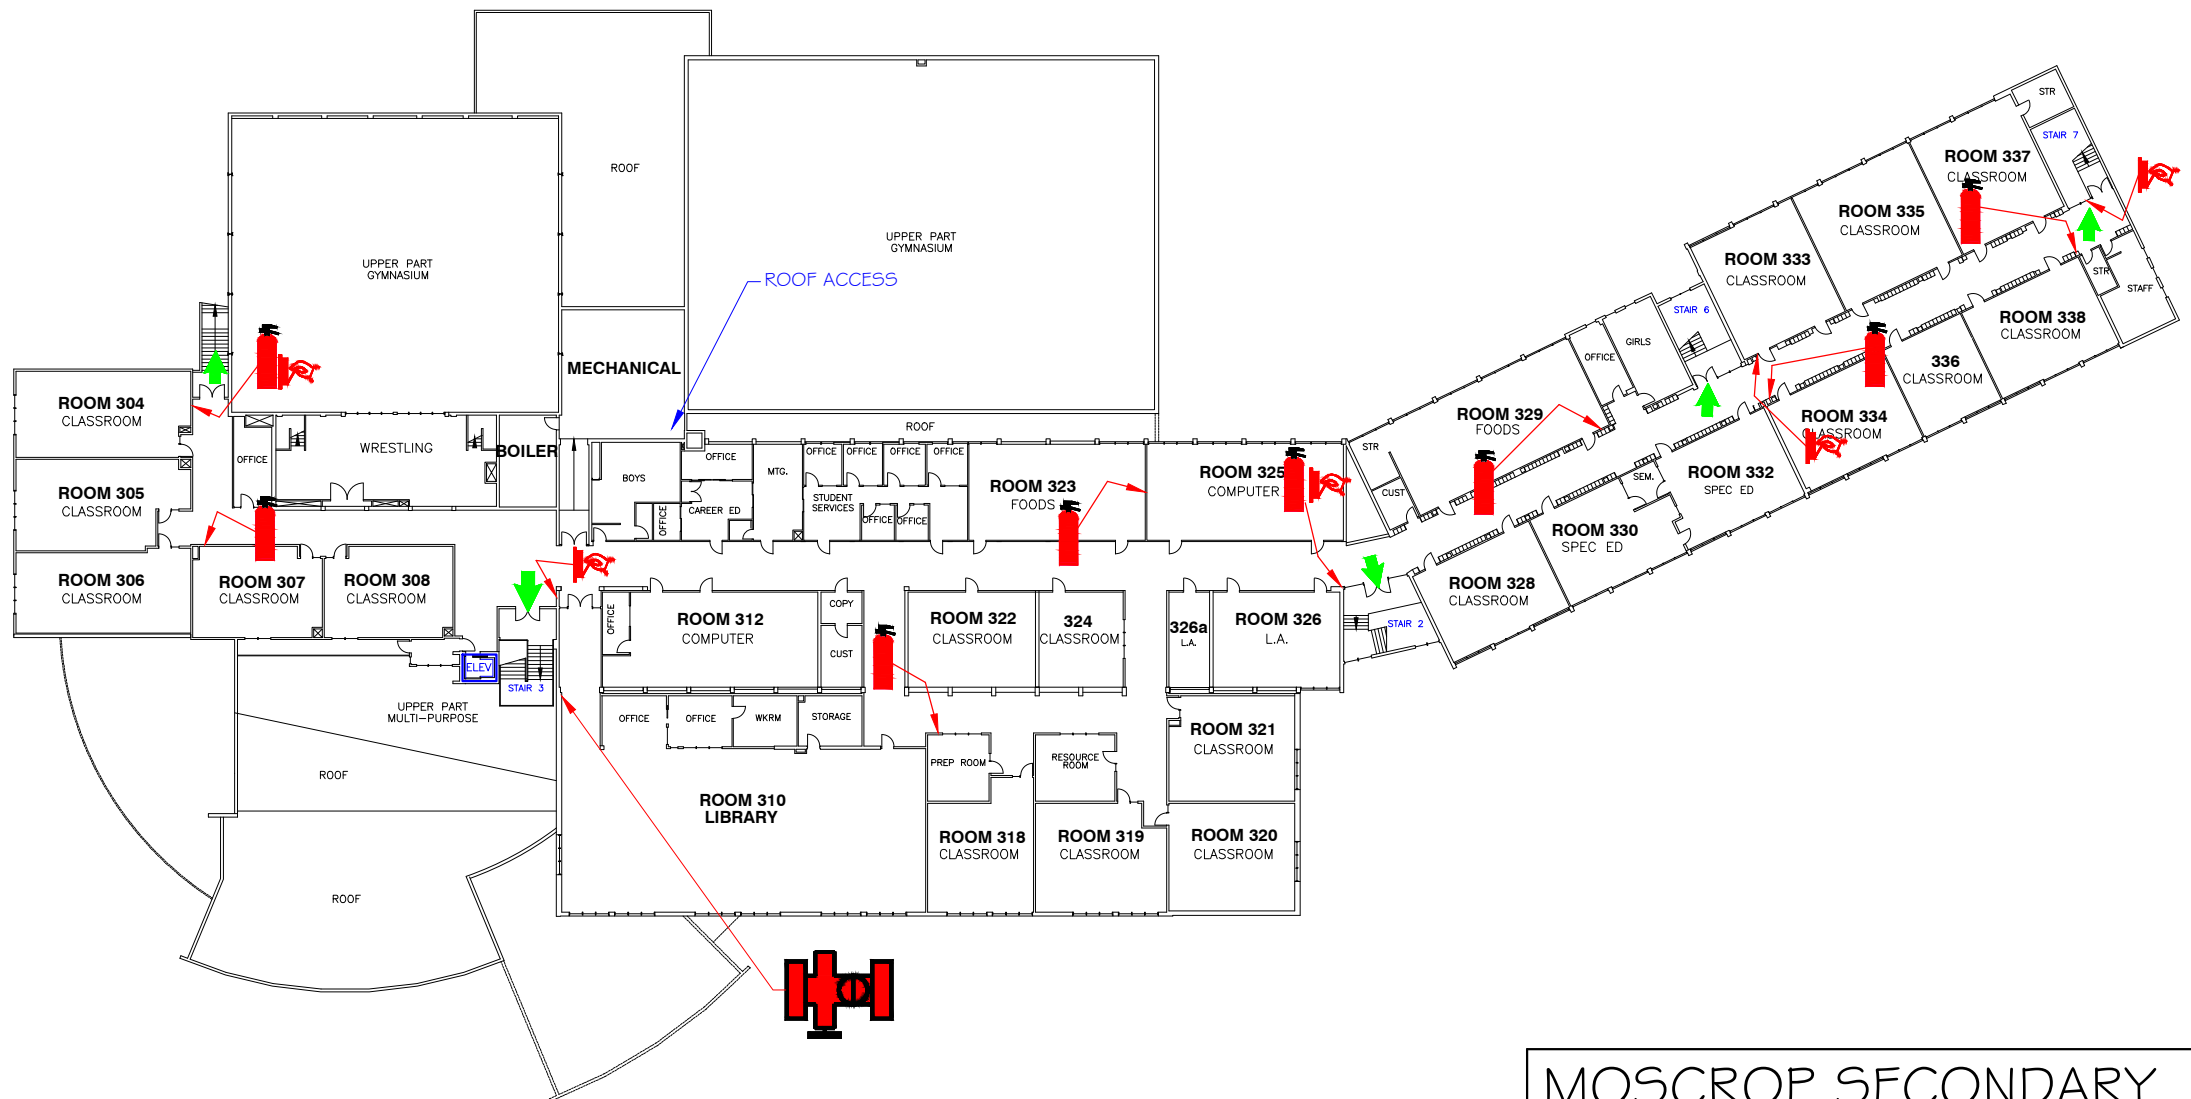

1 THIRD FLOOR
1:500



MOSCROP SECONDARY
4433 MOSCROP STREET
FACILITIES - RECORD DRAWING
NOVEMBER 20, 2024



BOARD OF EDUCATION
BURNABY
SCHOOL DISTRICT 41

F 1.4