
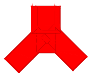



1 SITE PLAN
1:1500



| LEGEND | | | | | |
|---|---------|---|-----------------------|---|--------------|
|  | HYDRANT |  | FIRE DEPT. CONNECTION |  | GAS SHUT-OFF |

BYRNE CREEK SECONDARY

7777 18TH STREET


FACILITIES - RECORD DRAWING

JUNE 2020



BOARD OF EDUCATION
BURNABY
SCHOOL DISTRICT 41

F 1.1

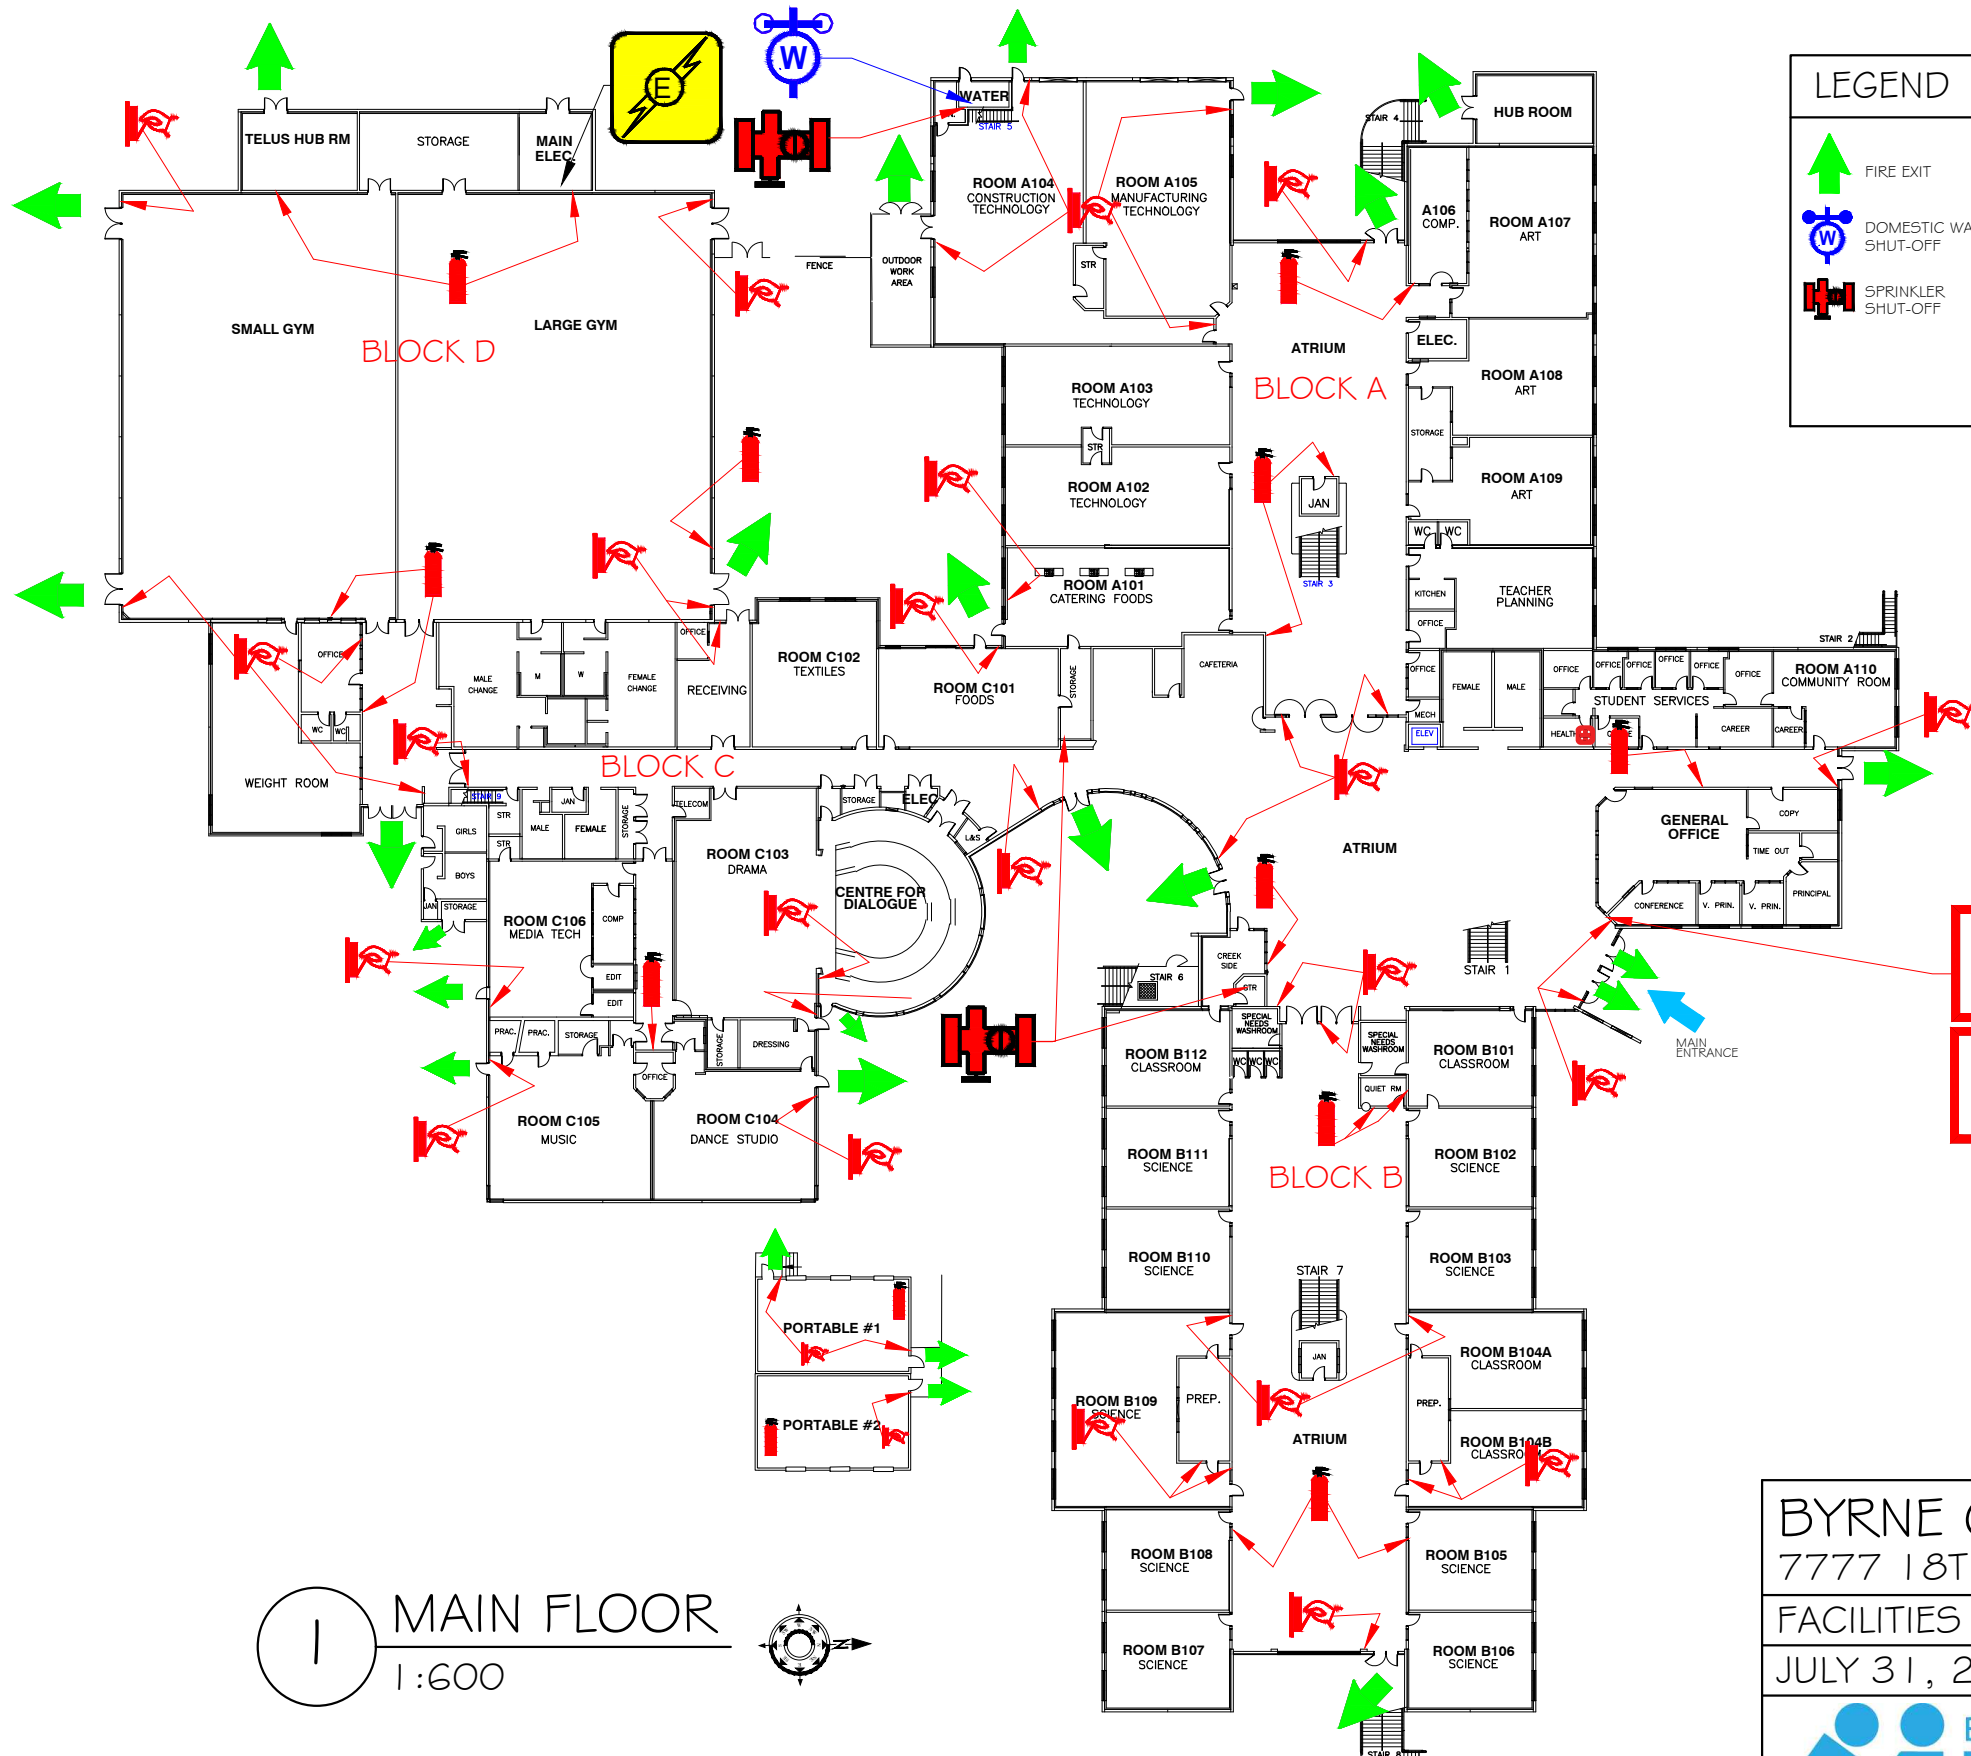


| LEGEND | | | | | |
|--------|-------------------------|--|------------------------|--|--------------------------|
| | FIRE EXIT | | FIRE EXTINGUISHER | | FIRE ALARM ANNUNCIATOR |
| | DOMESTIC WATER SHUT-OFF | | FIRE PULL STATION | | FIRE ALARM CONTROL PANEL |
| | SPRINKLER SHUT-OFF | | ELECTRICAL VAULT | | FIRE SAFETY PLAN |
| | | | FIRE WALL / FIRE DOORS | | |

FAAP
FSP

1 MAIN FLOOR
1:600

BYRNE CREEK SECONDARY
7777 18TH STREET
FACILITIES - RECORD DRAWING
JULY 31, 2025

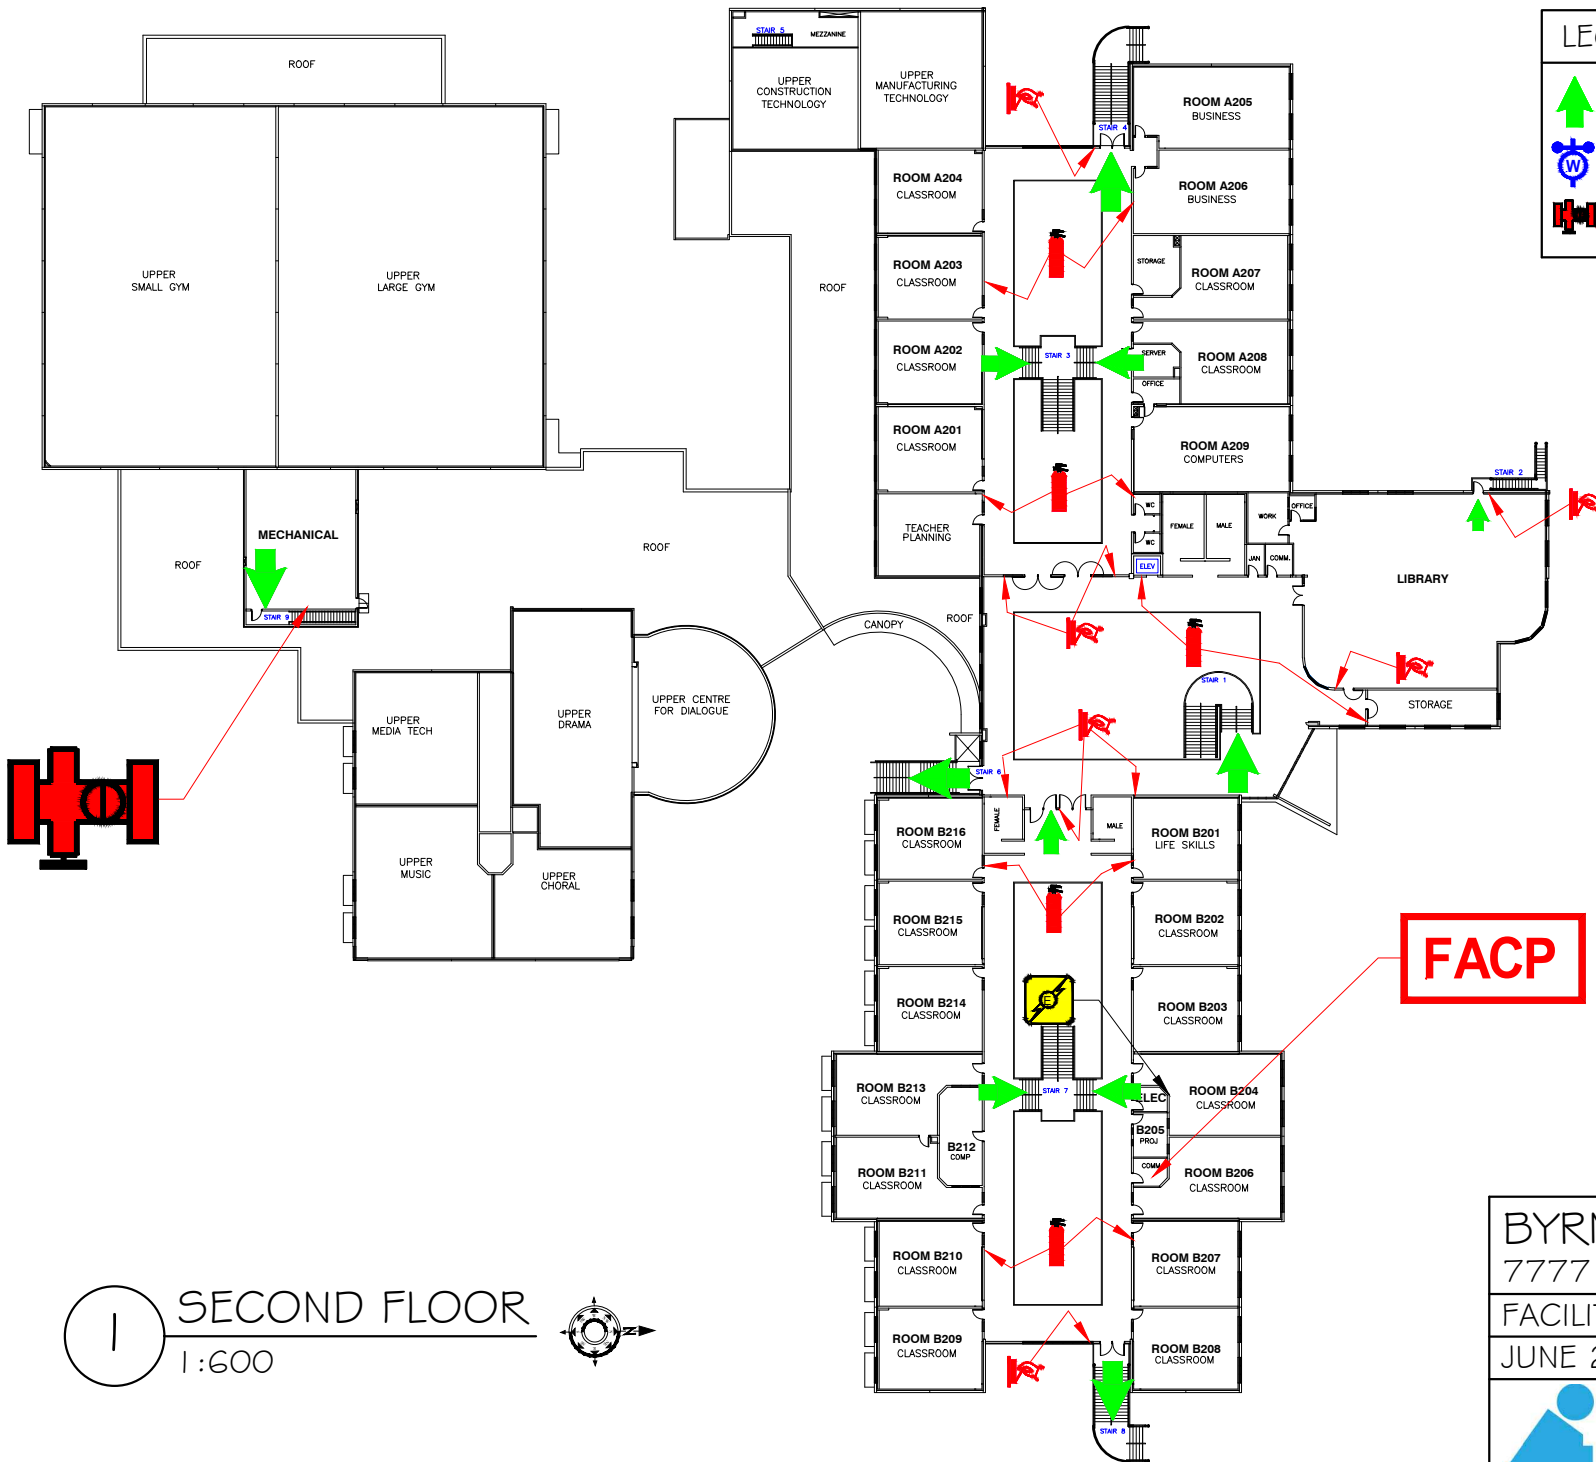

| LEGEND | | | | | |
|--------|-------------------------|--|-------------------|--|--------------------------|
| | FIRE EXIT | | FIRE EXTINGUISHER | | FIRE ALARM ANNUNCIATOR |
| | DOMESTIC WATER SHUT-OFF | | FIRE PULL STATION | | FIRE ALARM CONTROL PANEL |
| | SPRINKLER SHUT-OFF | | ELECTRICAL VAULT | | FIRE SAFETY PLAN |

FACP

1 SECOND FLOOR
1:600

BYRNE CREEK SECONDARY
7777 18TH STREET
FACILITIES - RECORD DRAWING
JUNE 2020