








### SECURITY LEGEND

-  CARD ACCESS - PROXIMITY
-  SECURITY ALARM PANEL
-  KEY BOX
-  PUSH BUTTON
-  SECURITY CAMERA  
FIXED
-  SECURITY CAMERA  
PAN-TILT-ZOOM (PTZ)

1 SECOND FLOOR  
1:600



BYRNE CREEK SECONDARY  
7777 18TH STREET  
FACILITIES - RECORD DRAWING  
NOVEMBER 2020

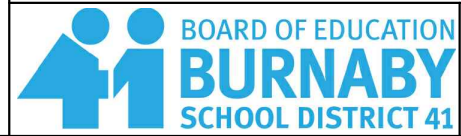

E 2.2  
SECURITY