
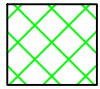
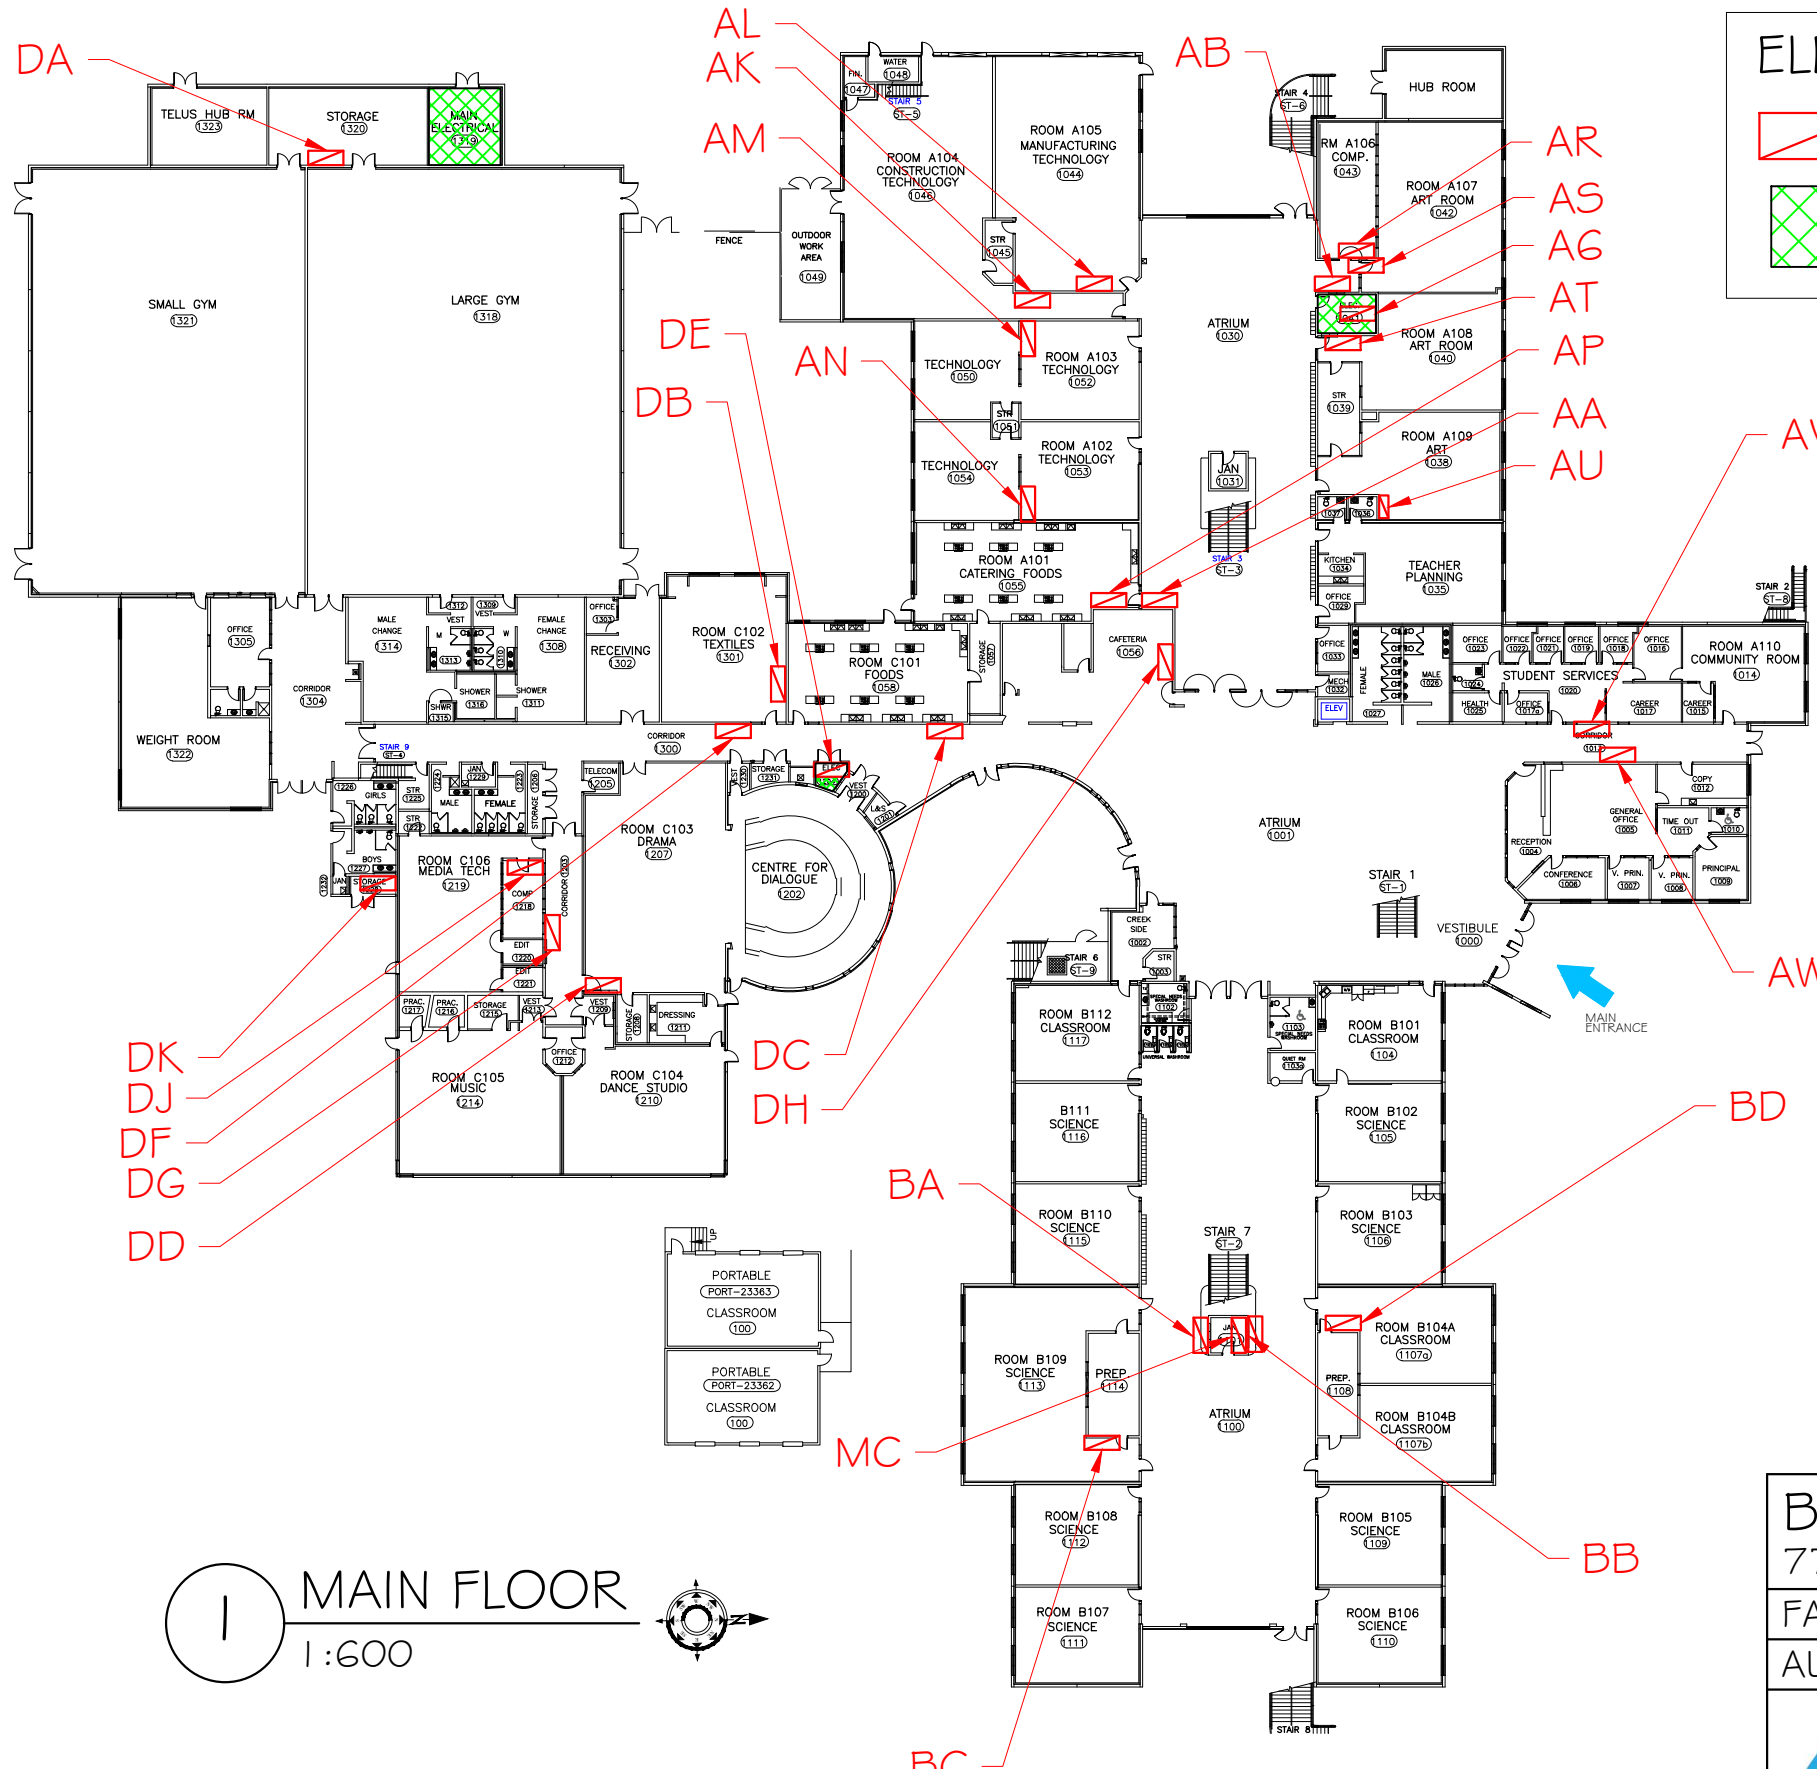
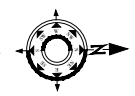


ELECTRICAL PANEL LEGEND


 ELECTRICAL PANEL
 ELECTRICAL ROOM



 MAIN FLOOR
 1:600



BYRNE CREEK SECONDARY
 7777 18TH STREET
 FACILITIES - RECORD DRAWING
 AUG 19, 2025



BOARD OF EDUCATION
BURNABY
 SCHOOL DISTRICT 41

E I . I
 PANELS