
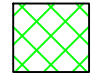
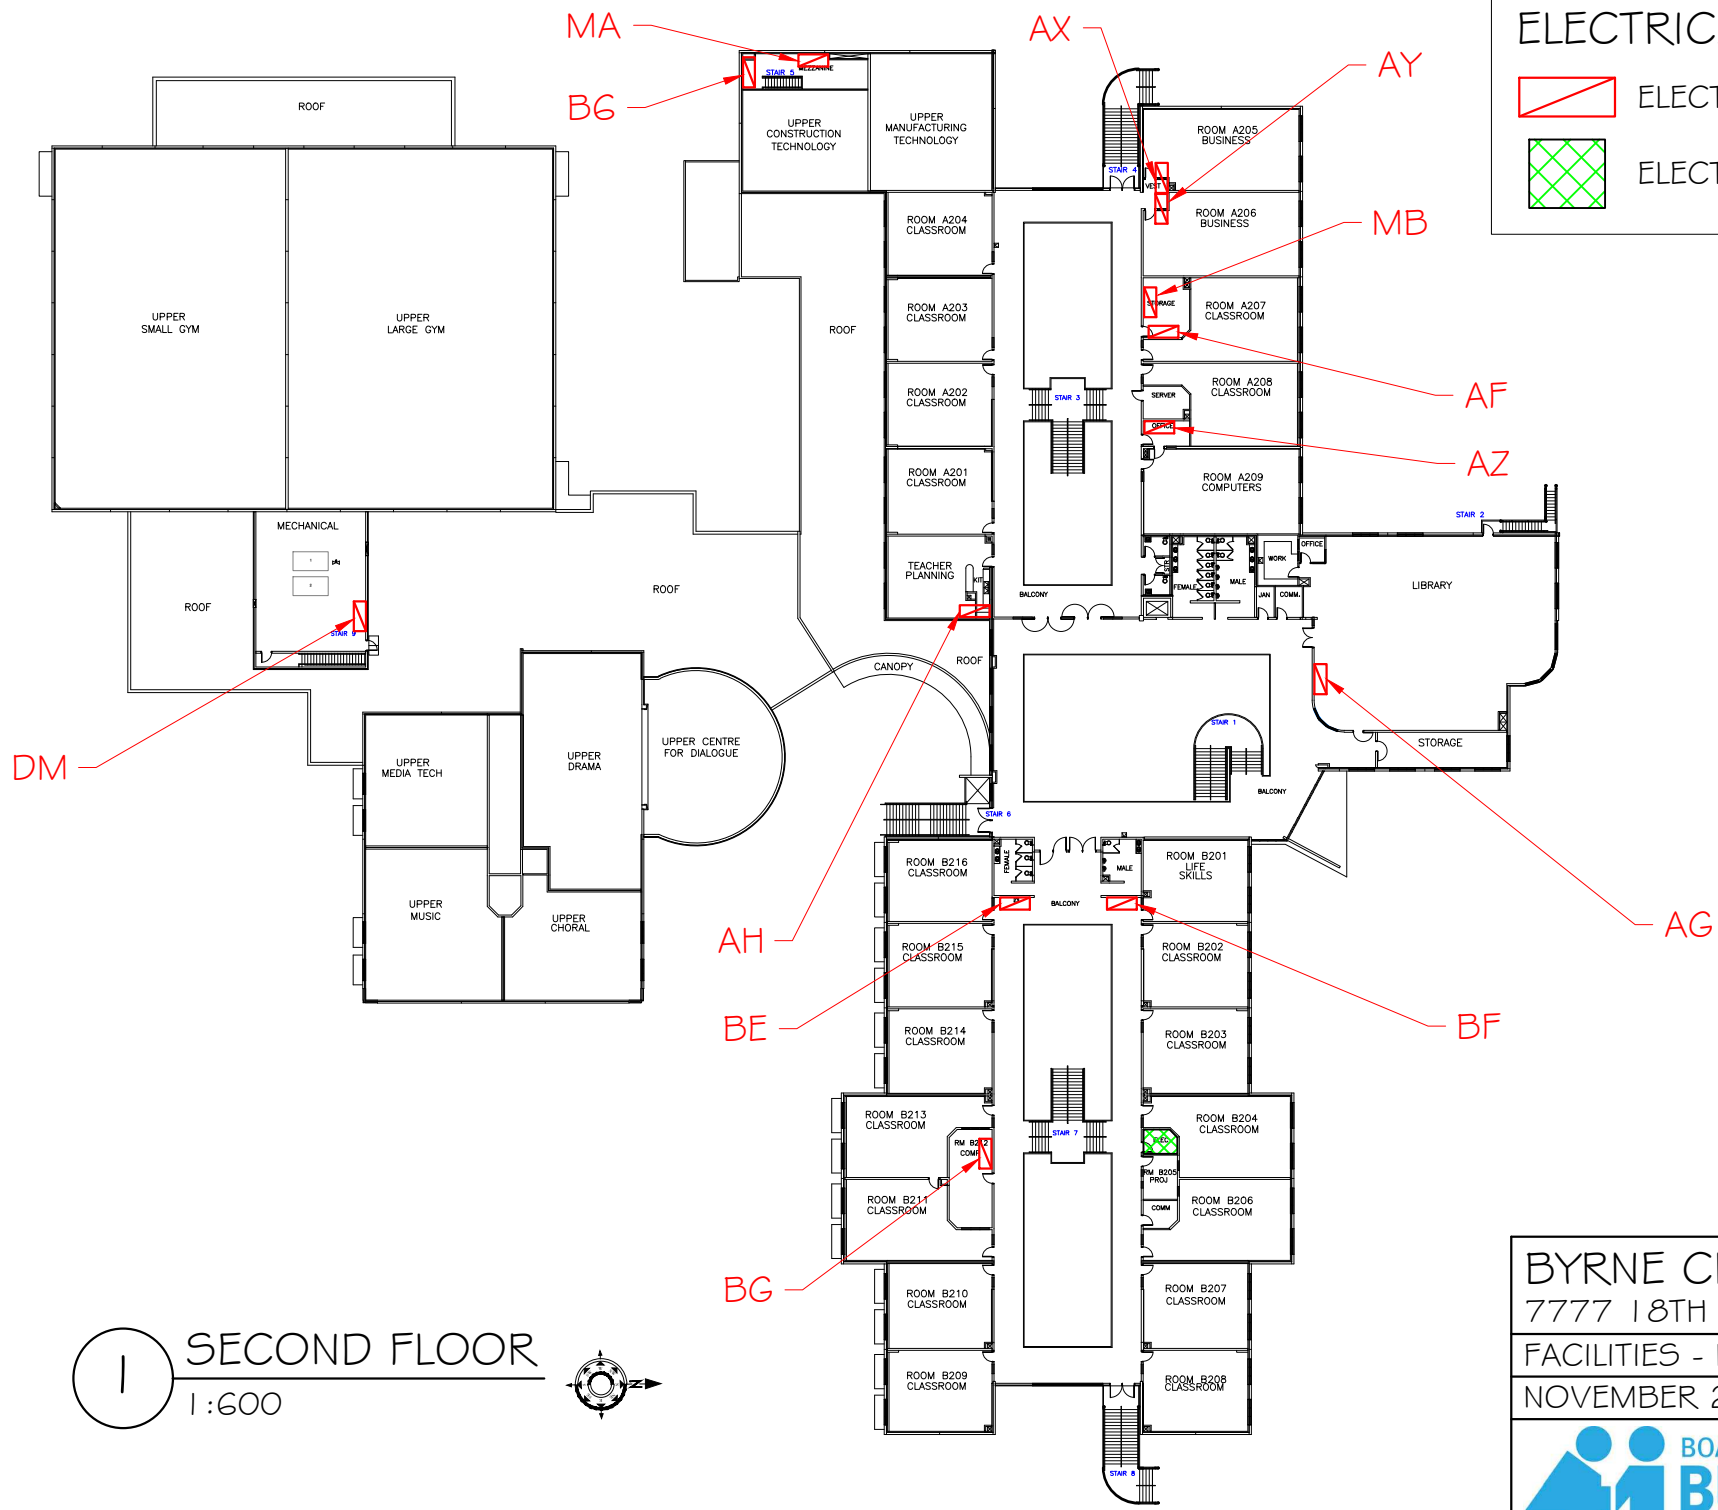


ELECTRICAL PANEL LEGEND

-  ELECTRICAL PANEL
-  ELECTRICAL ROOM



1 SECOND FLOOR
1:600



BYRNE CREEK SECONDARY
7777 18TH STREET
FACILITIES - RECORD DRAWING
NOVEMBER 2018



BOARD OF EDUCATION
BURNABY
SCHOOL DISTRICT 41

E 1.2
PANELS