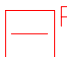

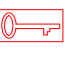







### SECURITY LEGEND


-  CARD ACCESS - PROXIMITY
-  SECURITY ALARM PANEL
-  KEY BOX
-  PUSH BUTTON
-  SECURITY CAMERA FIXED
-  SECURITY CAMERA PAN-TILT-ZOOM (PTZ)

1 MAIN FLOOR  
1:600



BYRNE CREEK SECONDARY  
7777 18TH STREET

FACILITIES - RECORD DRAWING  
AUG 19, 2025



BOARD OF EDUCATION  
**BURNABY**  
SCHOOL DISTRICT 41

E 2.1  
SECURITY