




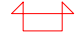

FIRE PROTECTION LEGEND

EMERGENCY LIGHTING


-  BATTERY PACK UNIT
-  REMOTE HEAD
-  EXIT SIGN - CEILING MOUNT
-  EXIT SIGN - WALL MOUNT
-  EXIT SIGN - WALL MOUNT FLUSH

FIRE DETECTION

-  HEAT DETECTOR
-  SMOKE DETECTOR

DEVICES

-  BELL

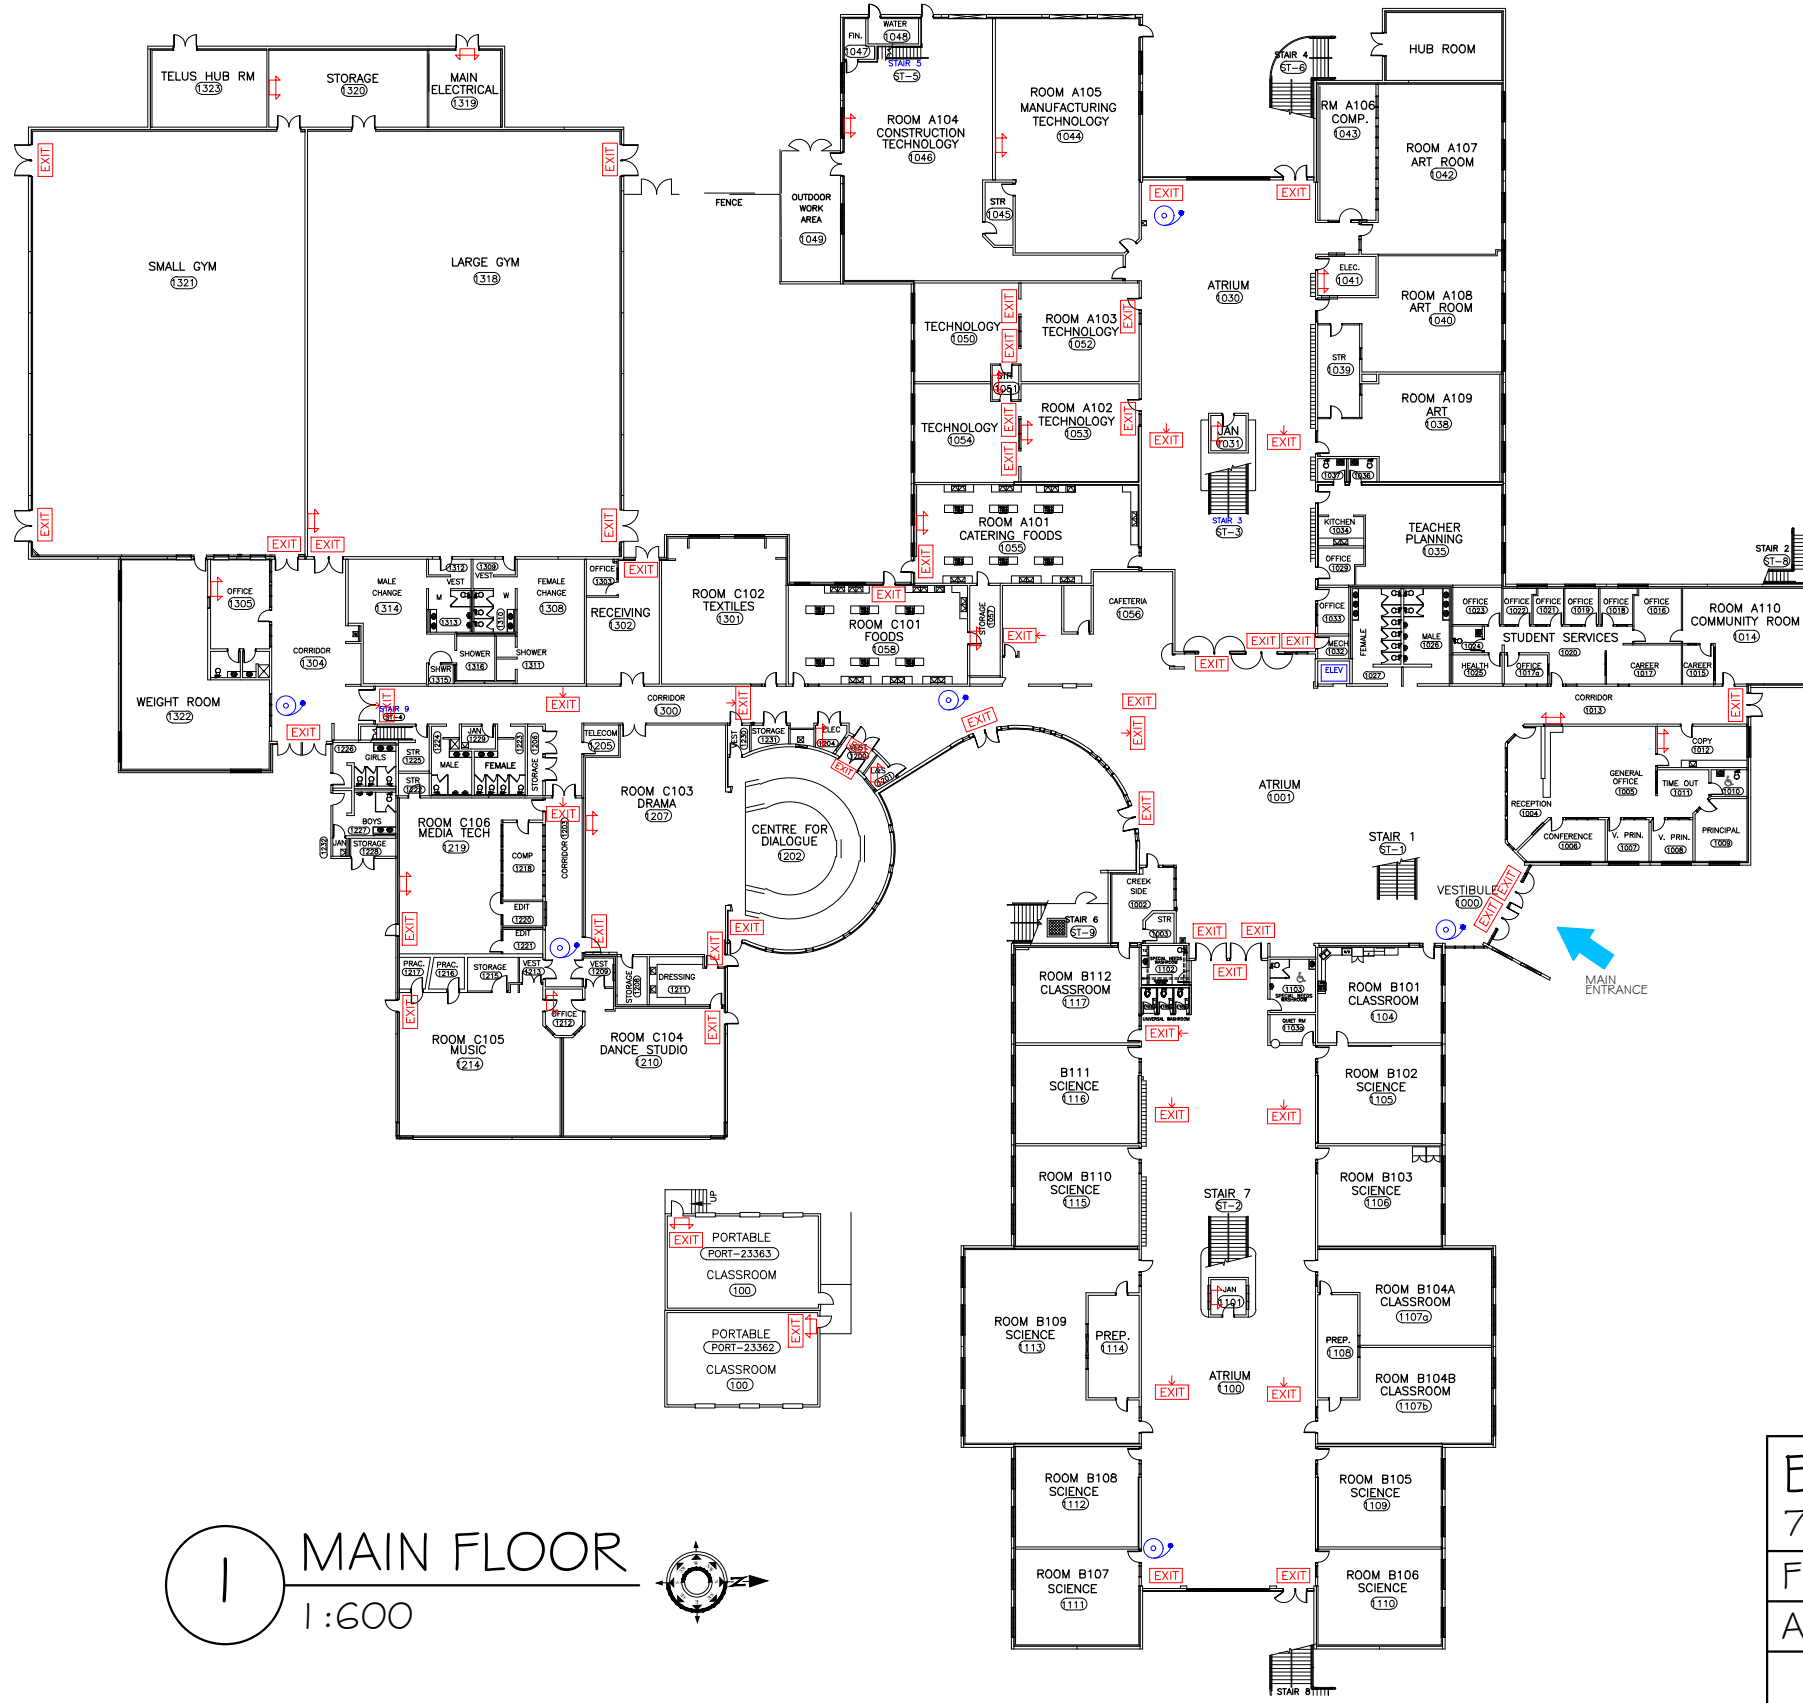

1 MAIN FLOOR
1:600



BYRNE CREEK SECONDARY

7777 18TH STREET

FACILITIES - RECORD DRAWING

AUG 19, 2025



F 2.1
FIRE
PROTECTION