

PLEAT - 16x25x1 Merv8 (4)

AHU #14
PLEAT - 20x20x1 Merv8 (3)


PLEAT - 20x20x1 Merv8 (1)
CEILING ACCESS

PLEAT 16x25x2 (4)

PLEAT - 12x24x1 (2)
SUSPENDED FROM CEILING

PLEAT - 20x20x1 Merv8 (1)
CEILING ACCESS

WSP 100D 16x24 1/2x1 PLEATED (2)
LOCATED IN FURNACE

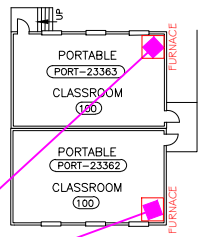

| MECHANICAL LEGEND | |
|-------------------|--------------------|
| | BOILER |
| | EXPANSION TANK |
| | HOT WATER TANK |
| | WATER SHUT-OFF |
| | GAS SHUT-OFF |
| | SPRINKLER SHUT-OFF |
| | FILTER INFORMATION |

BYRNE CREEK SECONDARY
 7777 18TH STREET
 FACILITIES - RECORD DRAWING
 AUG 19, 2025

