


GRASS
SPORTS FIELD
& TRACK

PORTABLE
CLASSROOM
PORT 124

PORTABLE
CLASSROOM
PORT 123

1 SITE PLAN
1:1500

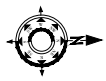

SECURITY LEGEND

-  SECURITY CAMERA
FIXED
-  SECURITY CAMERA
PAN-TILT-ZOOM (PTZ)

BYRNE CREEK SECONDARY
7777 18TH STREET
FACILITIES - RECORD DRAWING
NOVEMBER 2020



E 2.3
SECURITY