






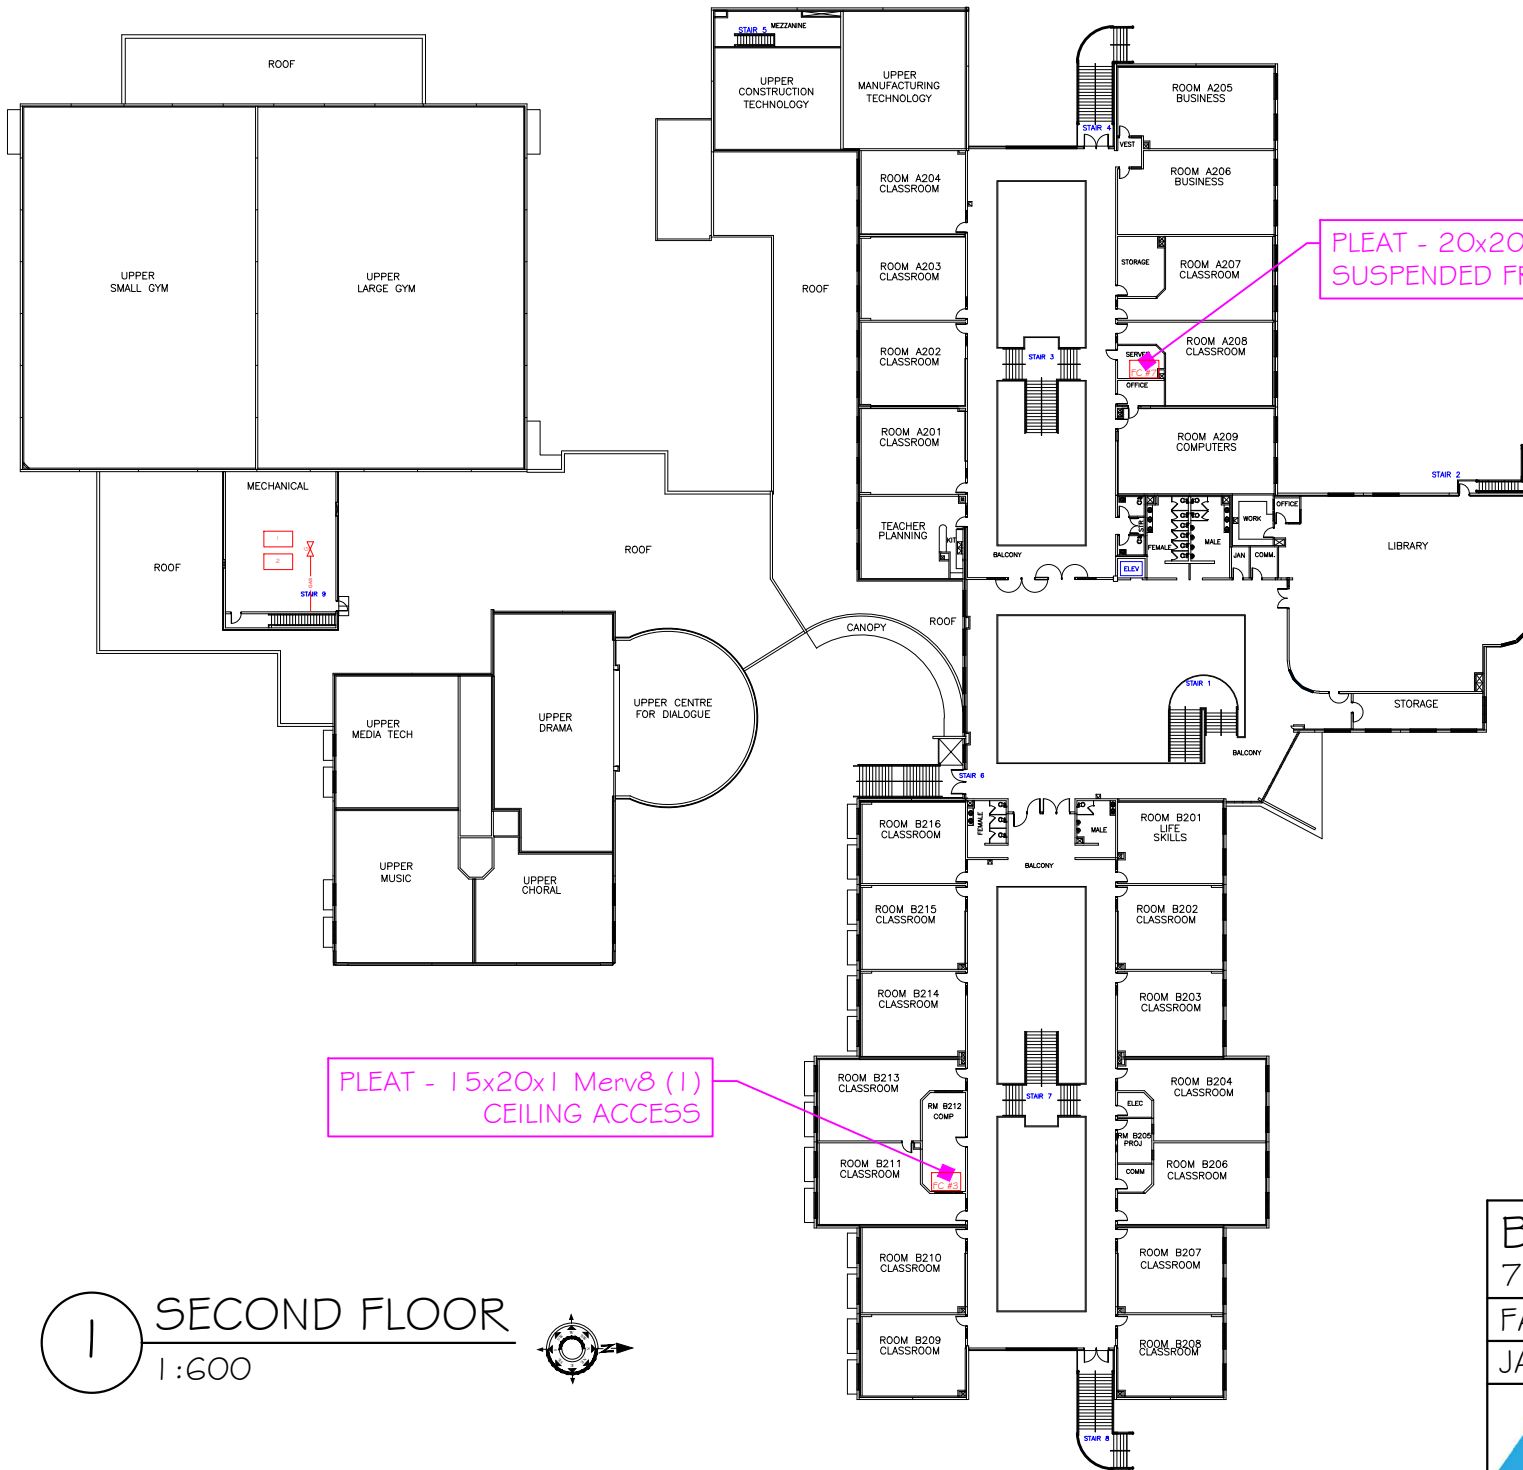


MECHANICAL LEGEND

-  BOILER
-  EXPANSION TANK
-  HOT WATER TANK
-  WATER SHUT-OFF
-  GAS SHUT-OFF
-  SPRINKLER SHUT-OFF
-  FILTER INFORMATION




PLEAT - 20x20x1 Merv8 (1)
SUSPENDED FROM CEILING

PLEAT - 15x20x1 Merv8 (1)
CEILING ACCESS

1 SECOND FLOOR
1:600



BYRNE CREEK SECONDARY
7777 18TH STREET
FACILITIES - RECORD DRAWING
JANUARY 2021

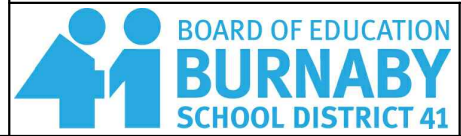

M 1.2