






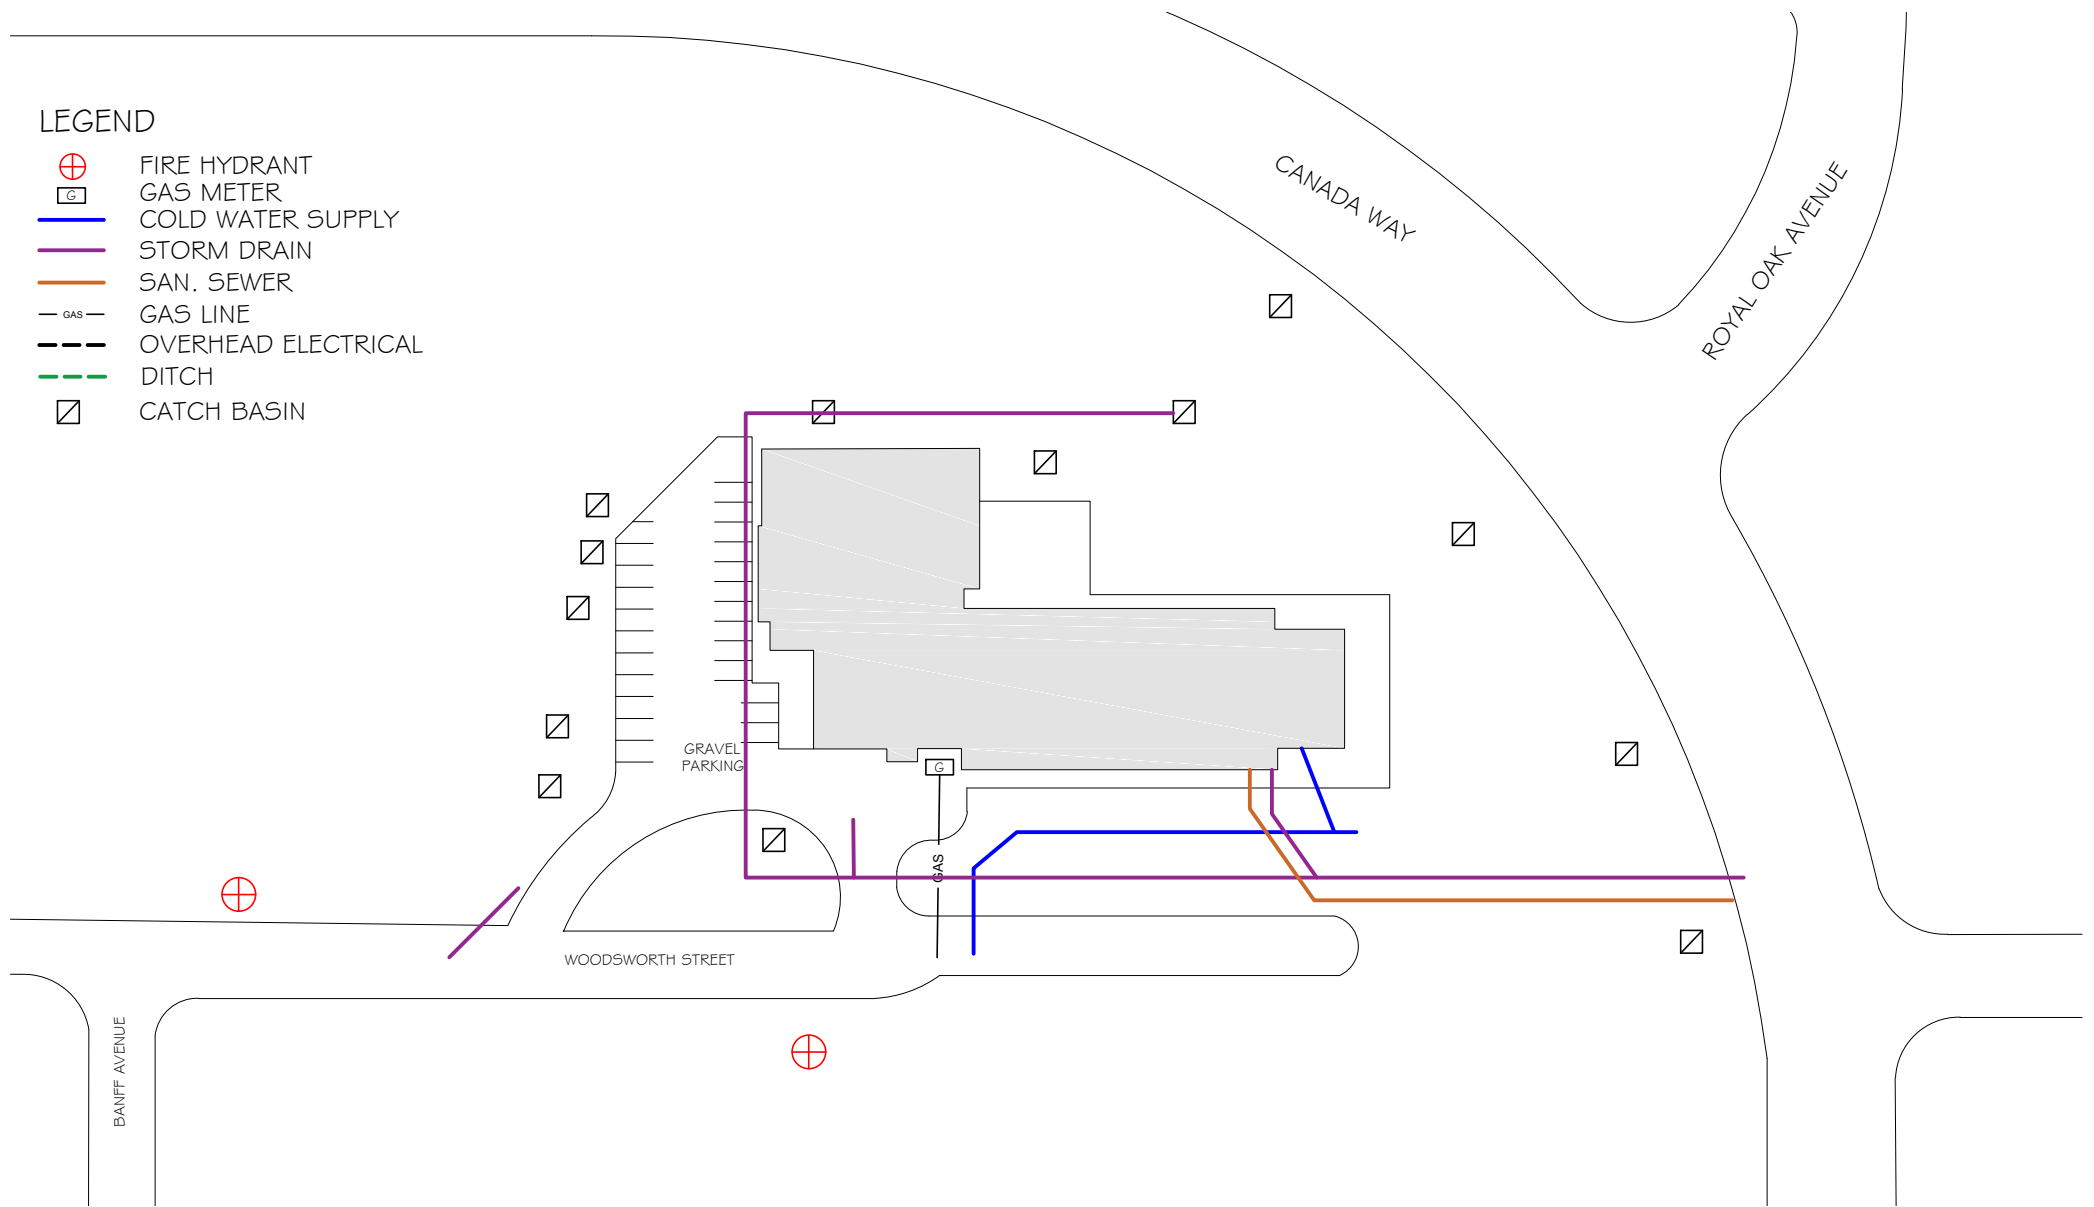



LEGEND

-  FIRE HYDRANT
-  GAS METER
-  COLD WATER SUPPLY
-  STORM DRAIN
-  SAN. SEWER
-  GAS LINE
-  OVERHEAD ELECTRICAL
-  DITCH
-  CATCH BASIN



1 CIVIL SITE PLAN  1:750

CANADA WAY ED. CENTRE
 5310 WOODSWORTH STREET
 FACILITIES - RECORD DRAWING
 OCTOBER 2018

 <p>BOARD OF EDUCATION BURNABY SCHOOL DISTRICT 41</p>	<p>C 1.1</p>
---	--------------