



1 SITE PLAN
1:750

LEGEND

	HYDRANT		GAS SHUT-OFF
---	---------	--	--------------

CANADA WAY ED. CENTRE


5310 WOODSWORTH STREET

FACILITIES - RECORD DRAWING

APRIL 2020



F 1.1

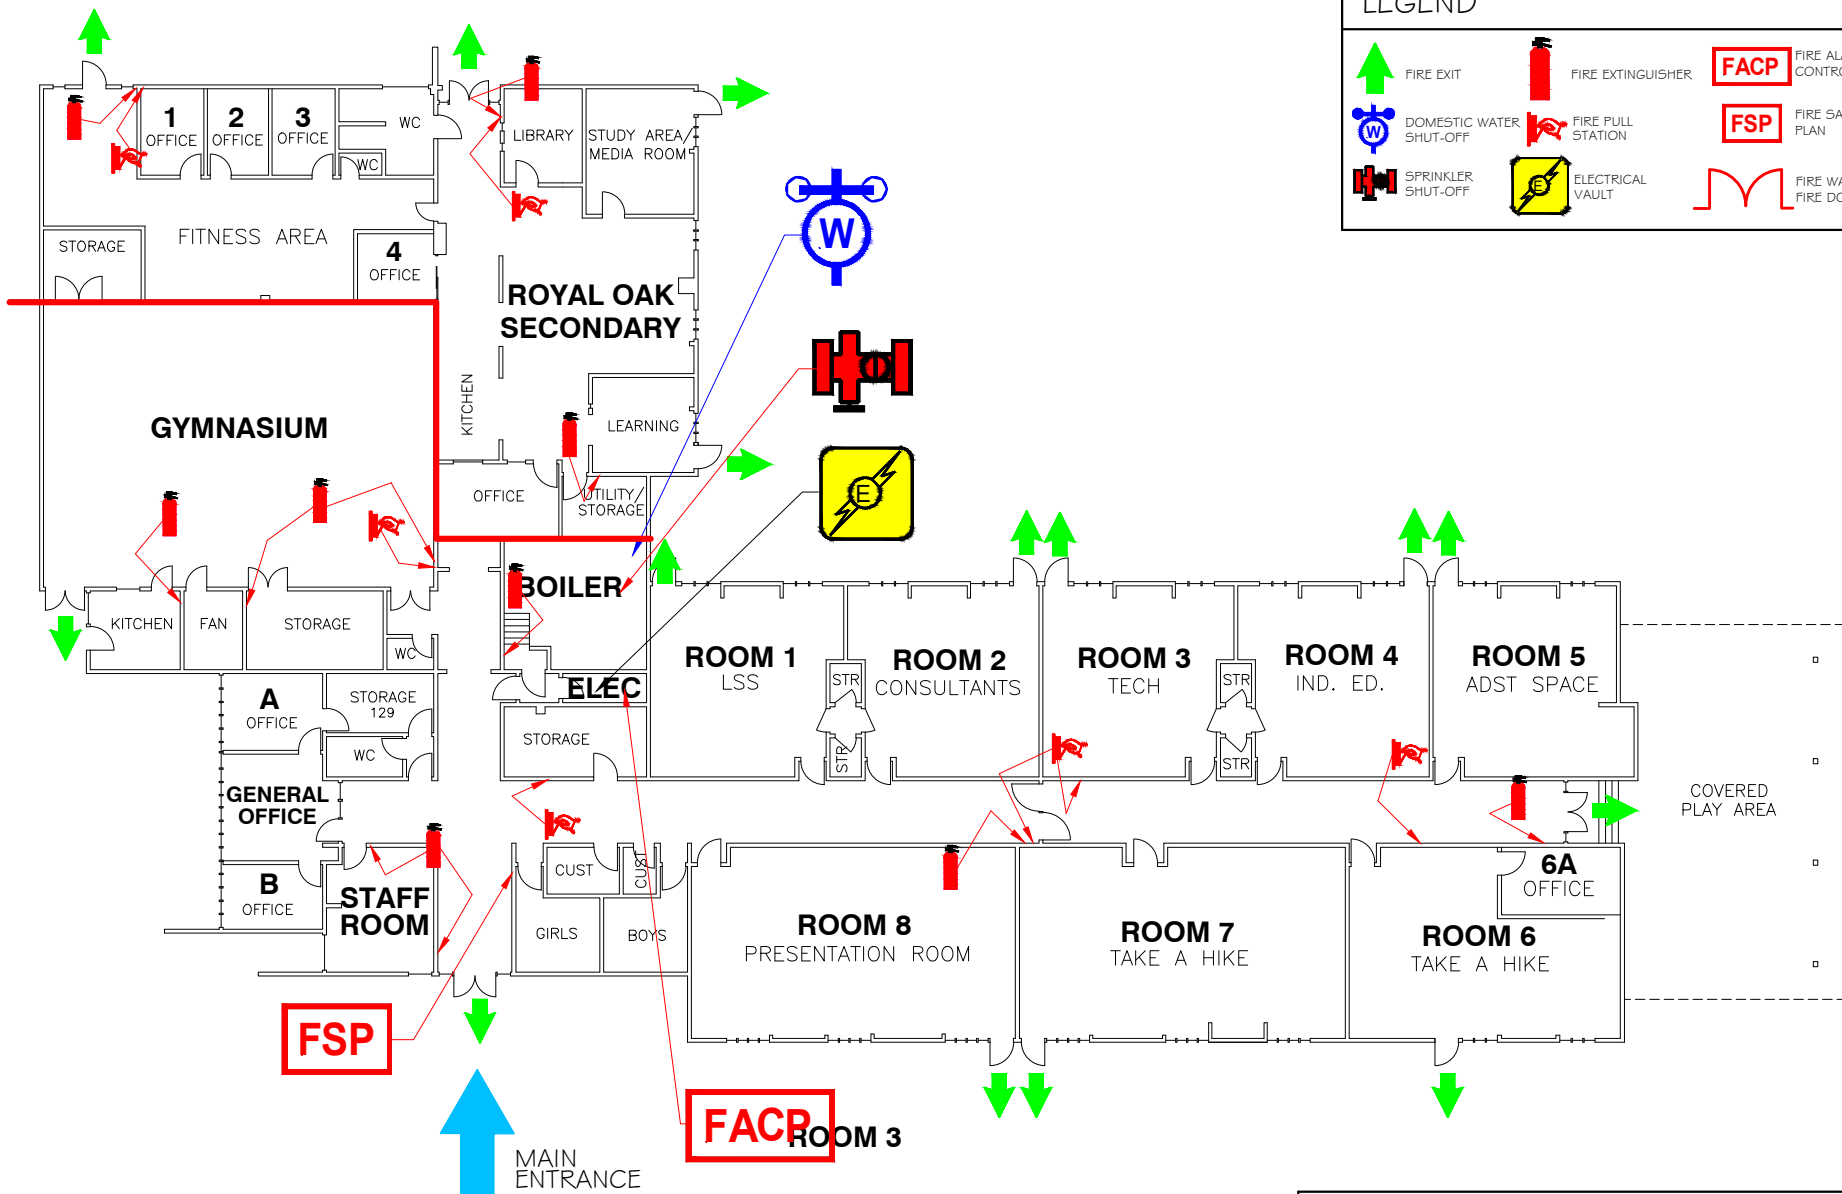

LEGEND			
	FIRE EXIT		FIRE ALARM CONTROL PANEL
	FIRE EXTINGUISHER		FIRE SAFETY PLAN
	DOMESTIC WATER SHUT-OFF		FIRE PULL STATION
	SPRINKLER SHUT-OFF		ELECTRICAL VAULT
	FIRE WALL / FIRE DOORS		

1 MAIN FLOOR
1:250

CANADA WAY ED. CENTRE	
5310 WOODSWORTH STREET	
FACILITIES - RECORD DRAWING	
APRIL 2020	
	F 1.2