


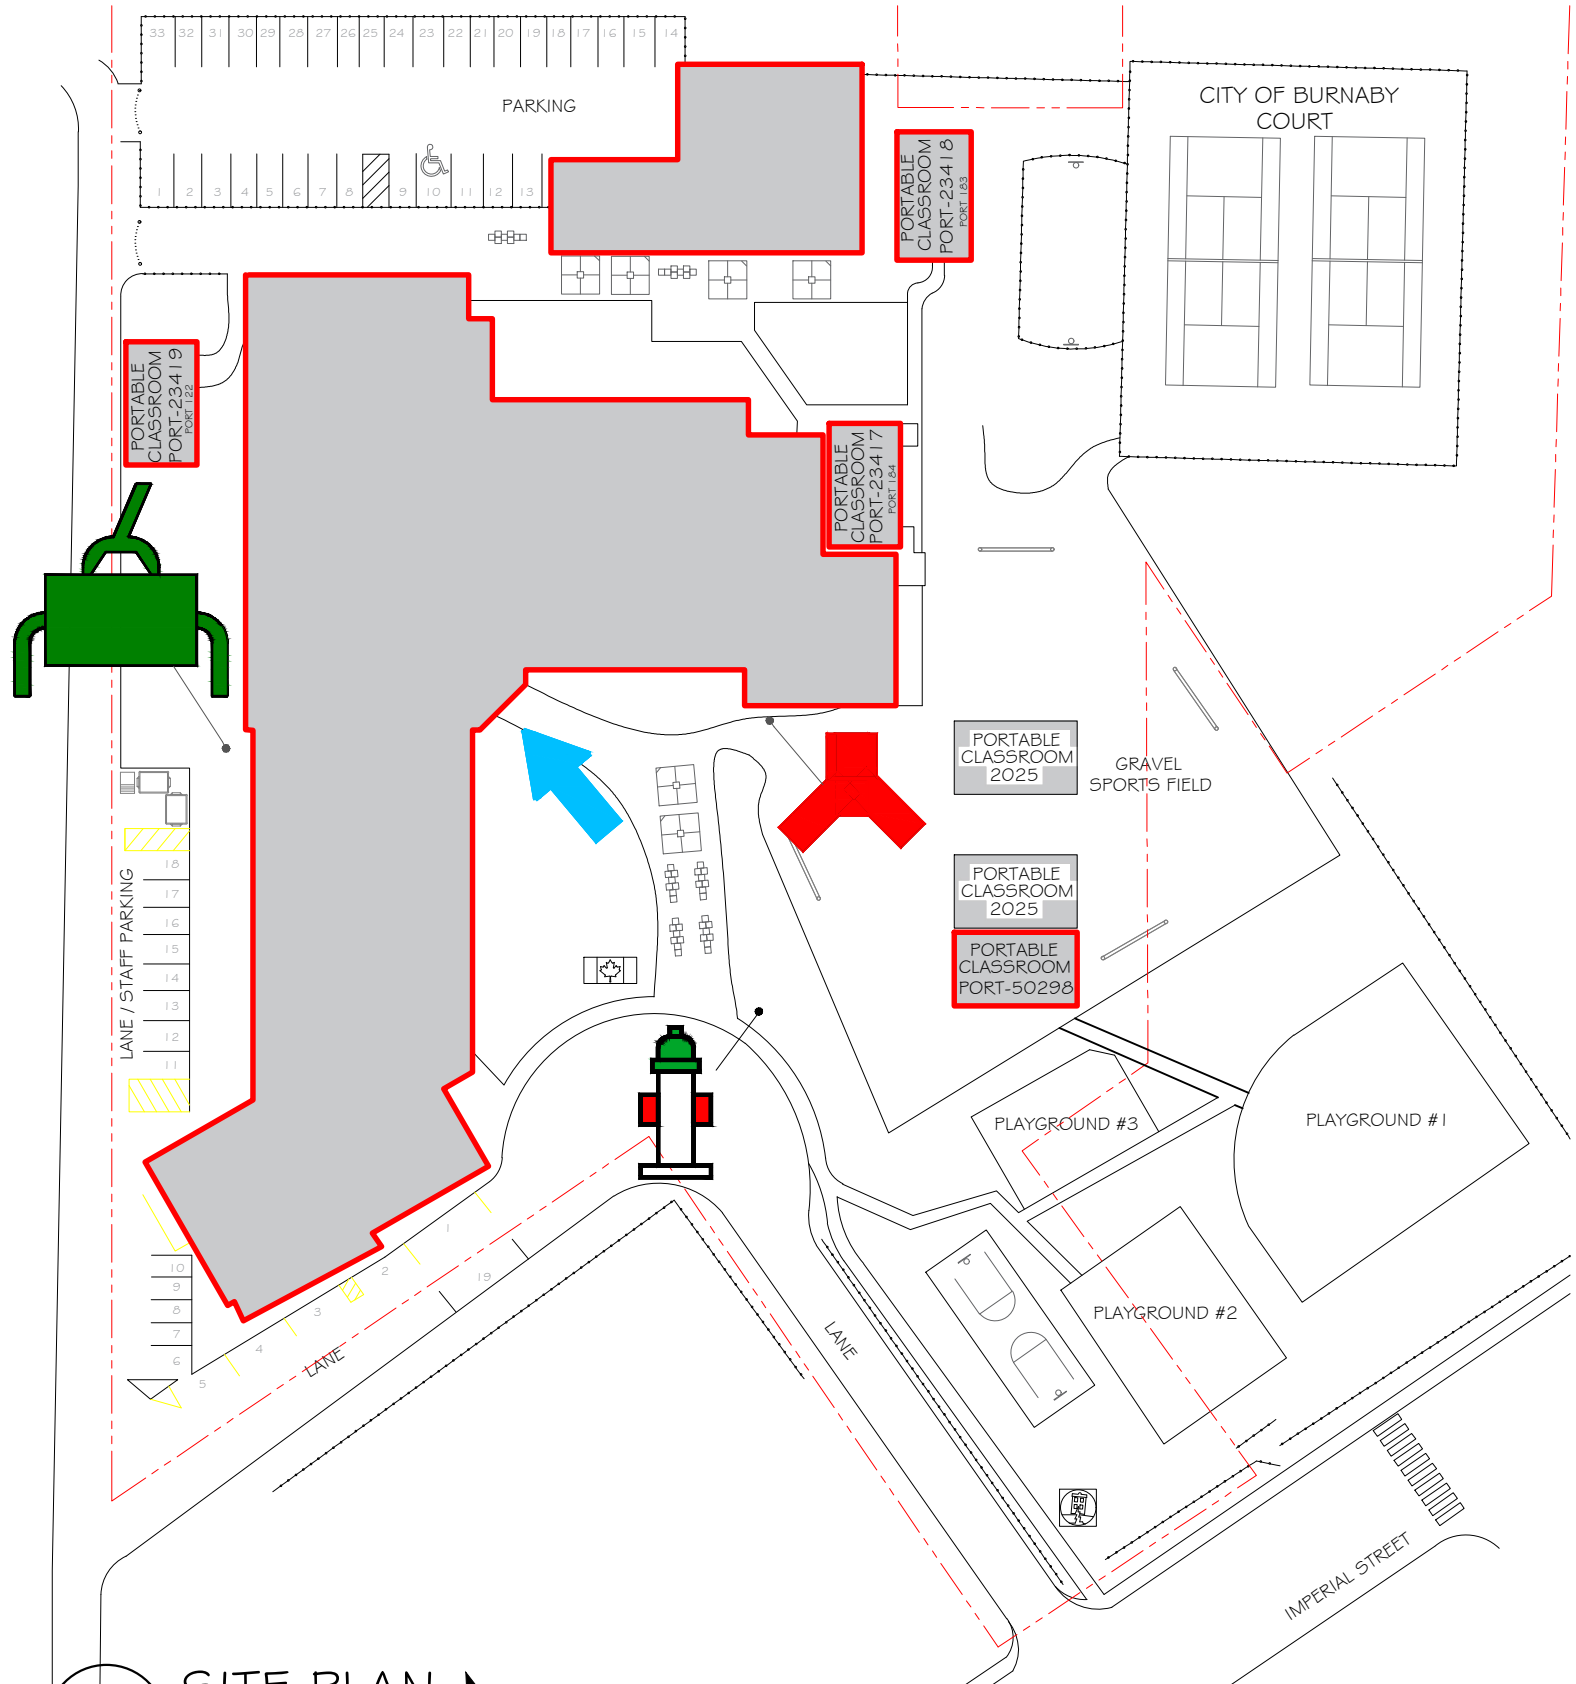


**LEGEND**

	HYDRANT		FIRE DEPT. CONNECTION		GAS SHUT-OFF
---	---------	---	-----------------------	---	--------------



**SITE PLAN**  
1:750




**MAYWOOD ELEMENTARY**  
4567 IMPERIAL STREET  
FACILITIES - RECORD DRAWING  
JANUARY 16, 2025




**BOARD OF EDUCATION**  
**BURNABY**  
SCHOOL DISTRICT 41

F 1.1

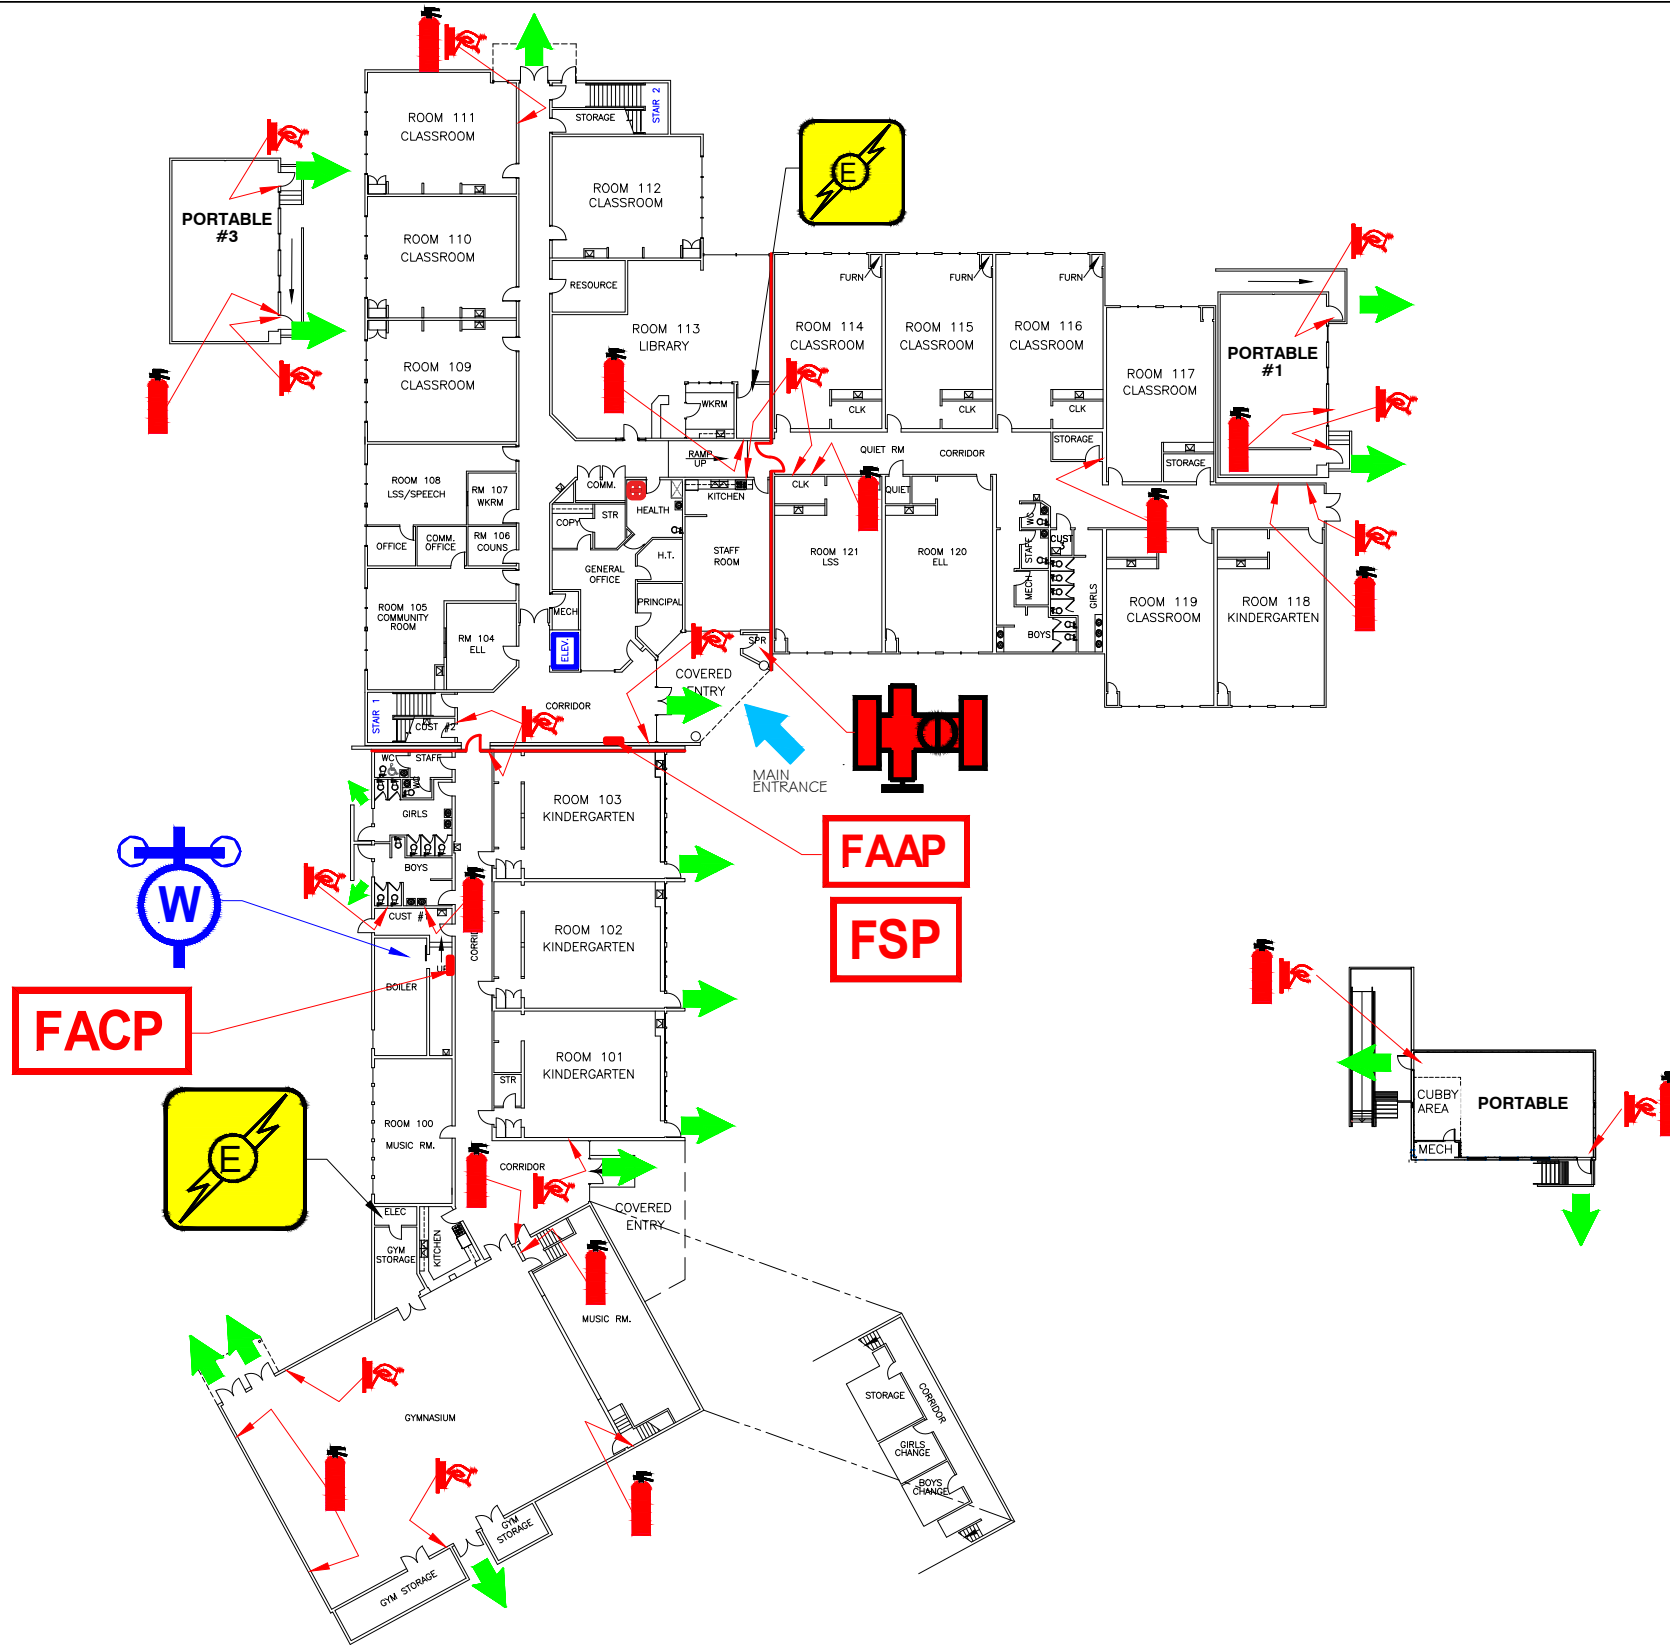


**1** BUILDING 1 - MAIN FLOOR  
1:500

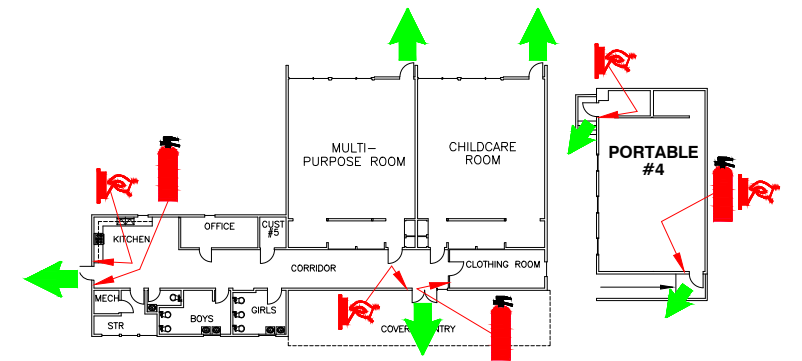

**2** BUILDING 2 - MAIN FLOOR  
1:500

LEGEND			
	FIRE EXIT		FIRE EXTINGUISHER
	DOMESTIC WATER SHUT-OFF		FIRE PULL STATION
	SPRINKLER SHUT-OFF		ELECTRICAL VAULT
	FAAP		FIRE ALARM ANNUNCIATOR
	FACP		FIRE ALARM CONTROL PANEL
	FSP		FIRE WALL / FIRE DOORS

MAYWOOD ELEMENTARY  
4567 IMPERIAL STREET  
FACILITIES - RECORD DRAWING  
JANUARY 16, 2025

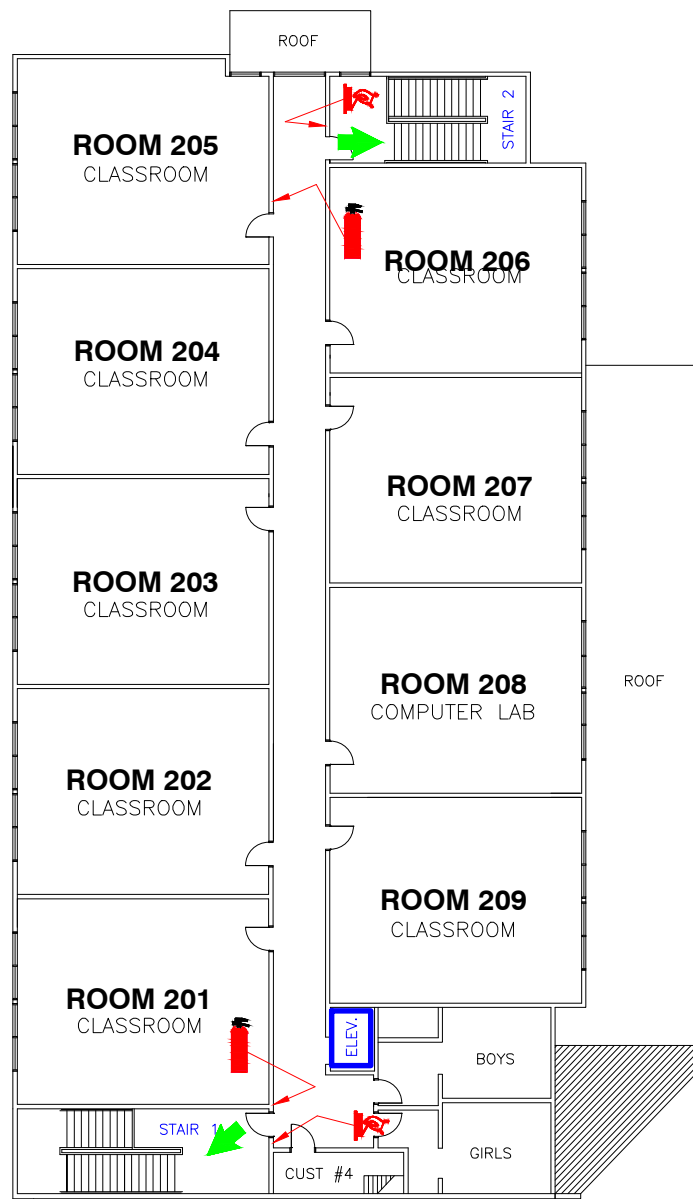

1
**BUILDING 1 - SECOND FLOOR**  
 1:250



<b>MAYWOOD ELEMENTARY</b> 4567 IMPERIAL STREET	
FACILITIES - RECORD DRAWING	
JUNE 2020	
	<b>F 1.3</b>