






LEGEND


-  FIRE HYDRANT
-  GAS METER
-  COLD WATER SUPPLY
-  STORM DRAIN
-  SAN. SEWER
-  GAS LINE
-  OVERHEAD ELECTRICAL
-  DITCH
-  CATCH BASIN



1 CIVIL SITE PLAN
1:750

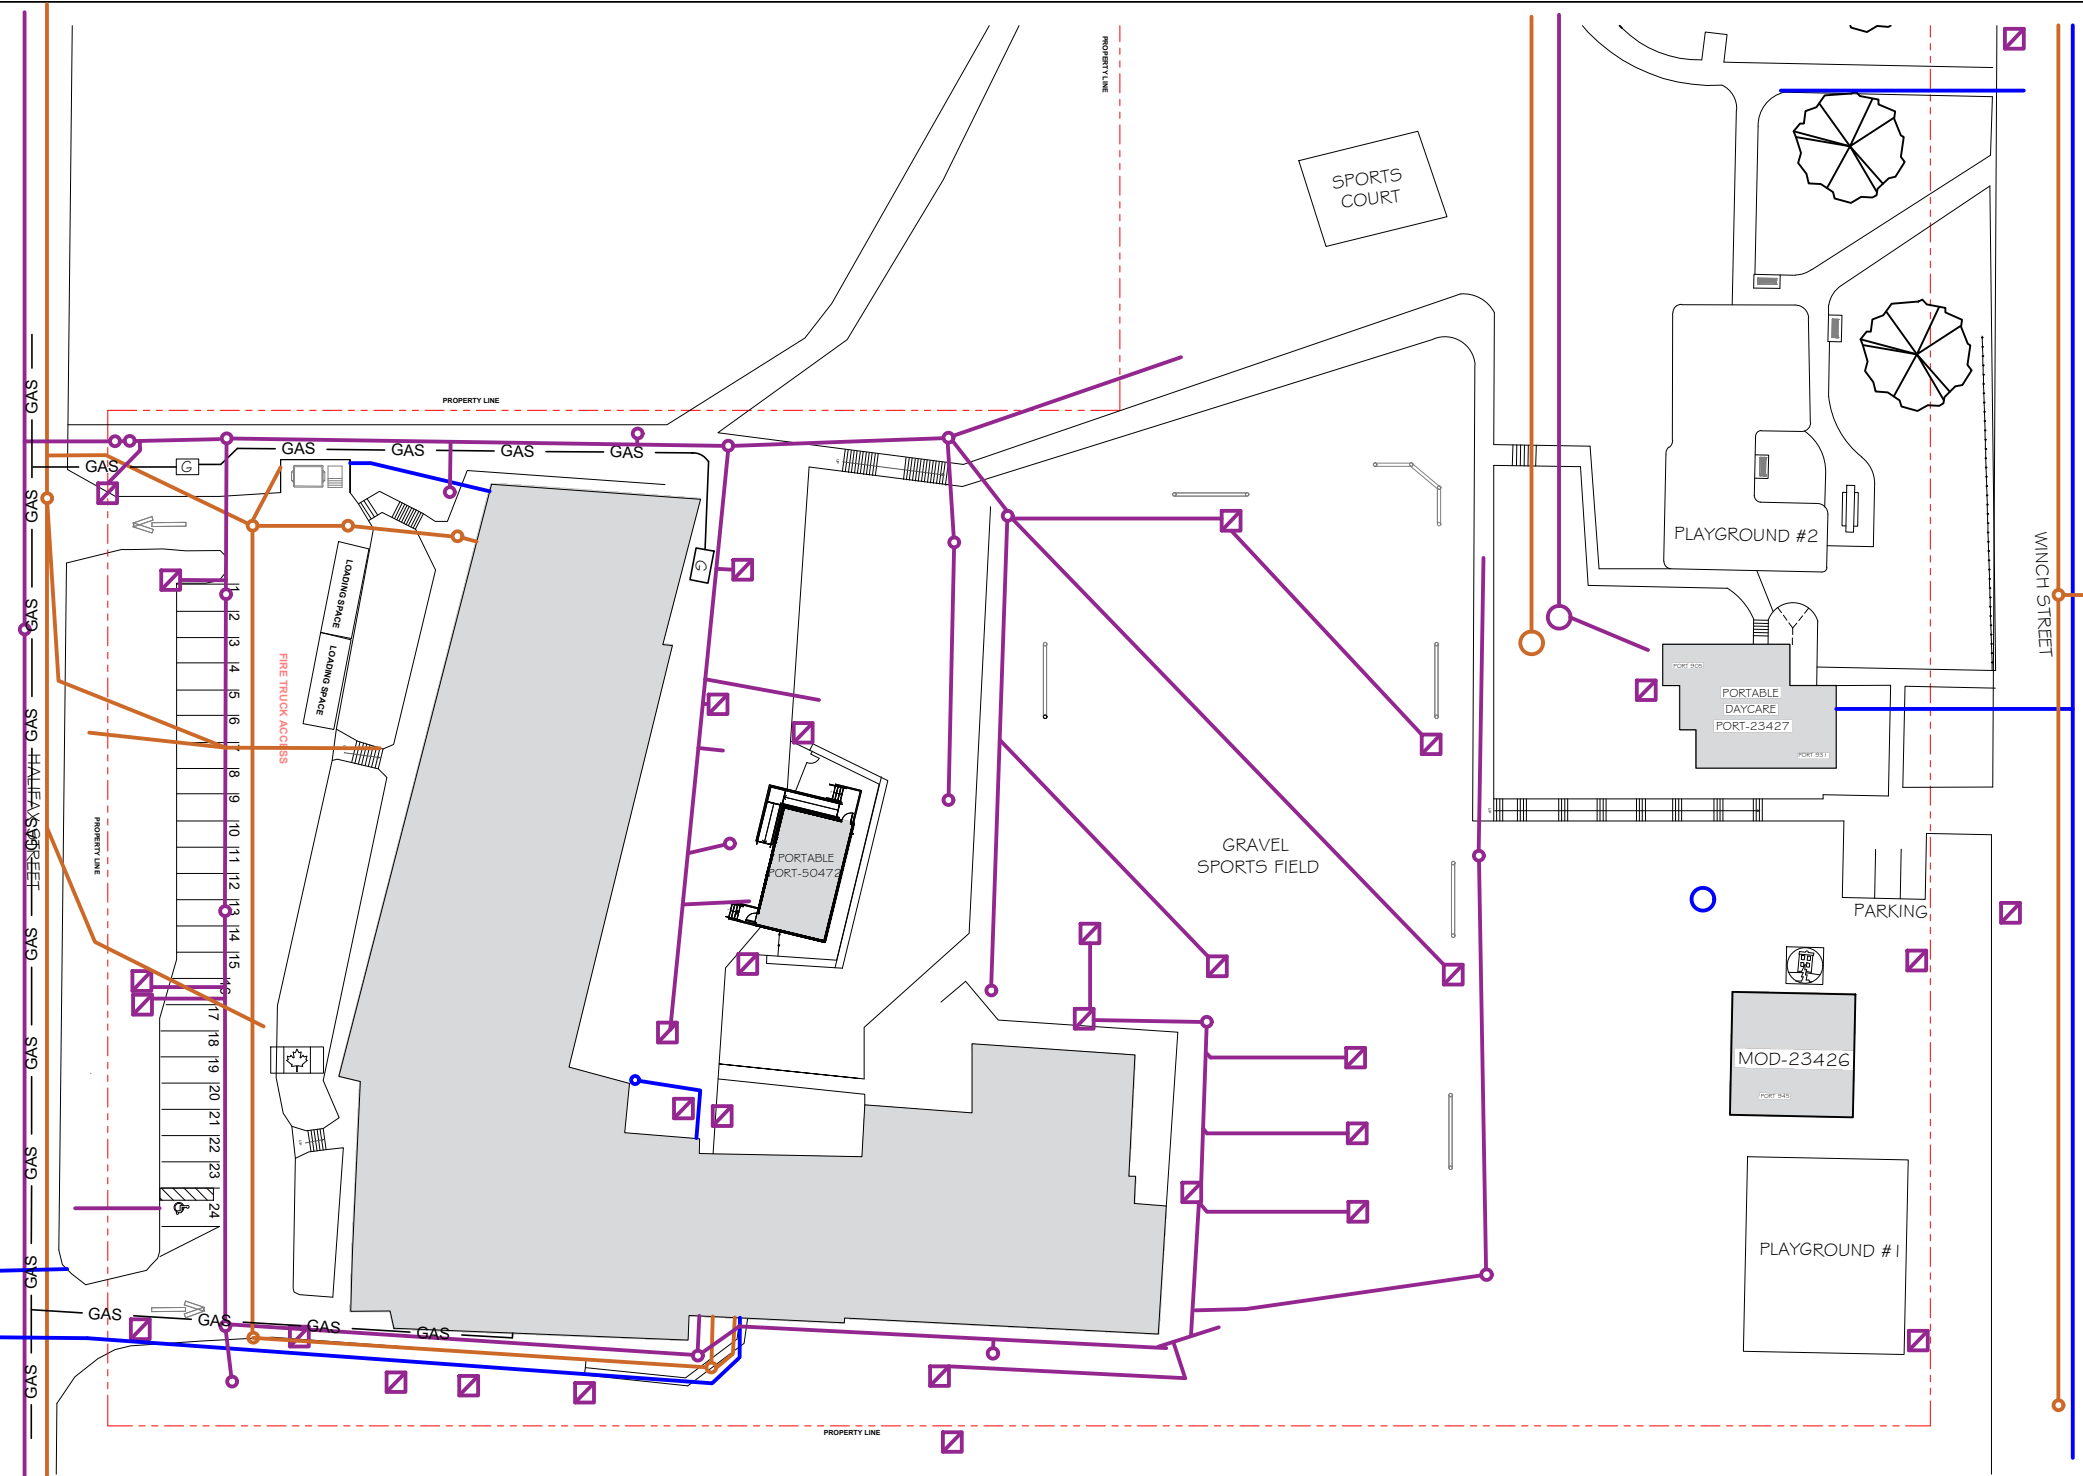

PARKCREST ELEMENTARY
6055 HALIFAX STREET
FACILITIES - RECORD DRAWING
JULY 14, 2025



BOARD OF EDUCATION
BURNABY
SCHOOL DISTRICT 41

C I . I