
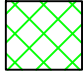
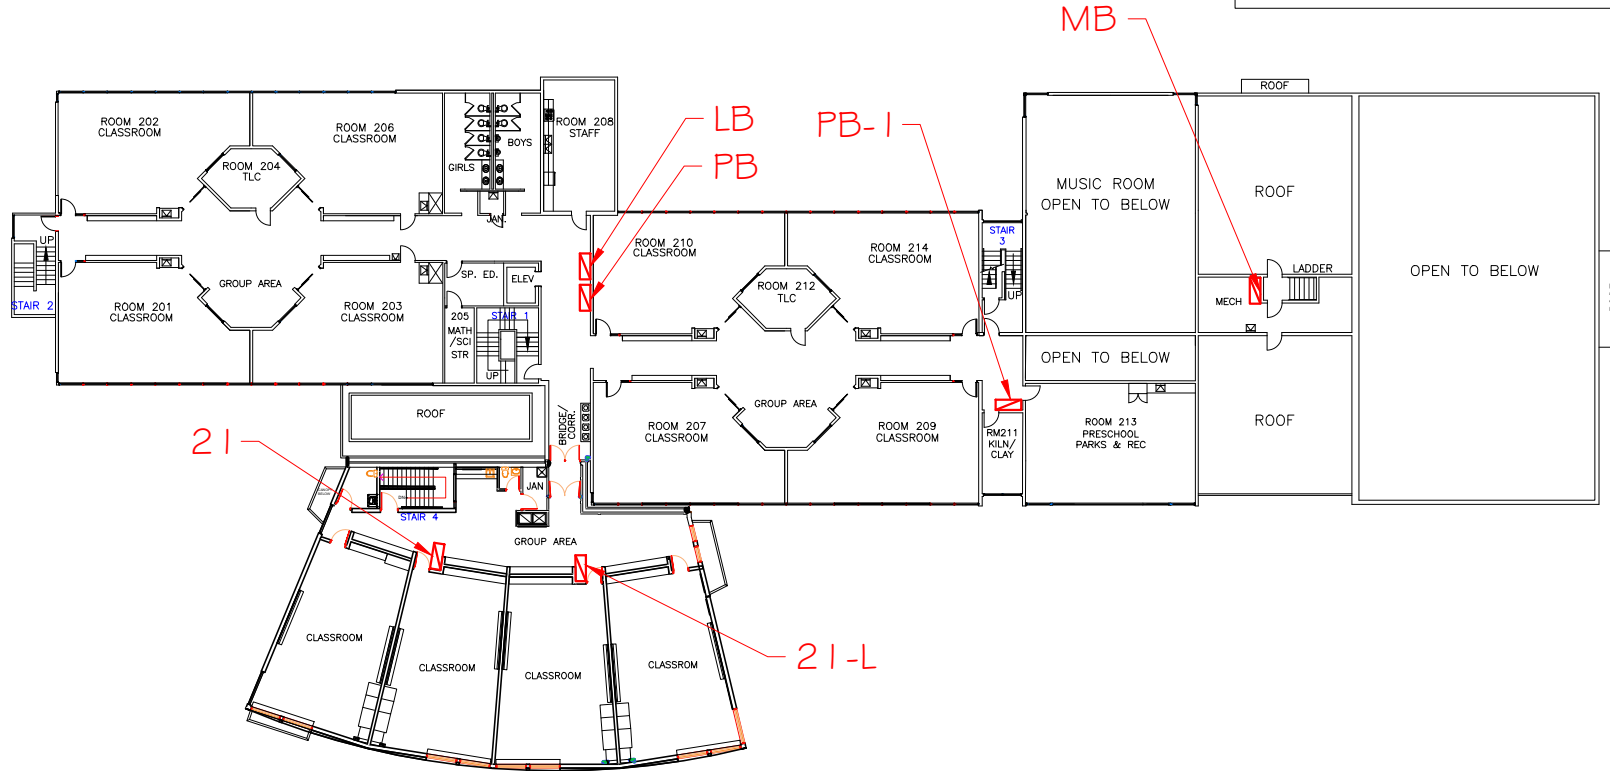


ELECTRICAL PANEL LEGEND

-  ELECTRICAL PANEL
-  ELECTRICAL ROOM



1 SECOND FLOOR
1:400



UNIVERSITY HIGHLANDS
9388 TOWER ROAD

FACILITIES - RECORD DRAWING

NOVEMBER 2018



E 1.2
PANELS