


LEGEND

- ROOF DRAIN
- ① S.B.S. ASPHALT SHINGLES 2020
- ② 4-PLY B.U.R. & GRAVEL 2017
- ③ 4-PLY B.U.R. & GRAVEL 2017
- ④ 4-PLY GLASS FELT & GRAVEL 2017
- ↗ DRAINAGE DIRECTION
- ▣ CHIMNEY
- VENT/CURB

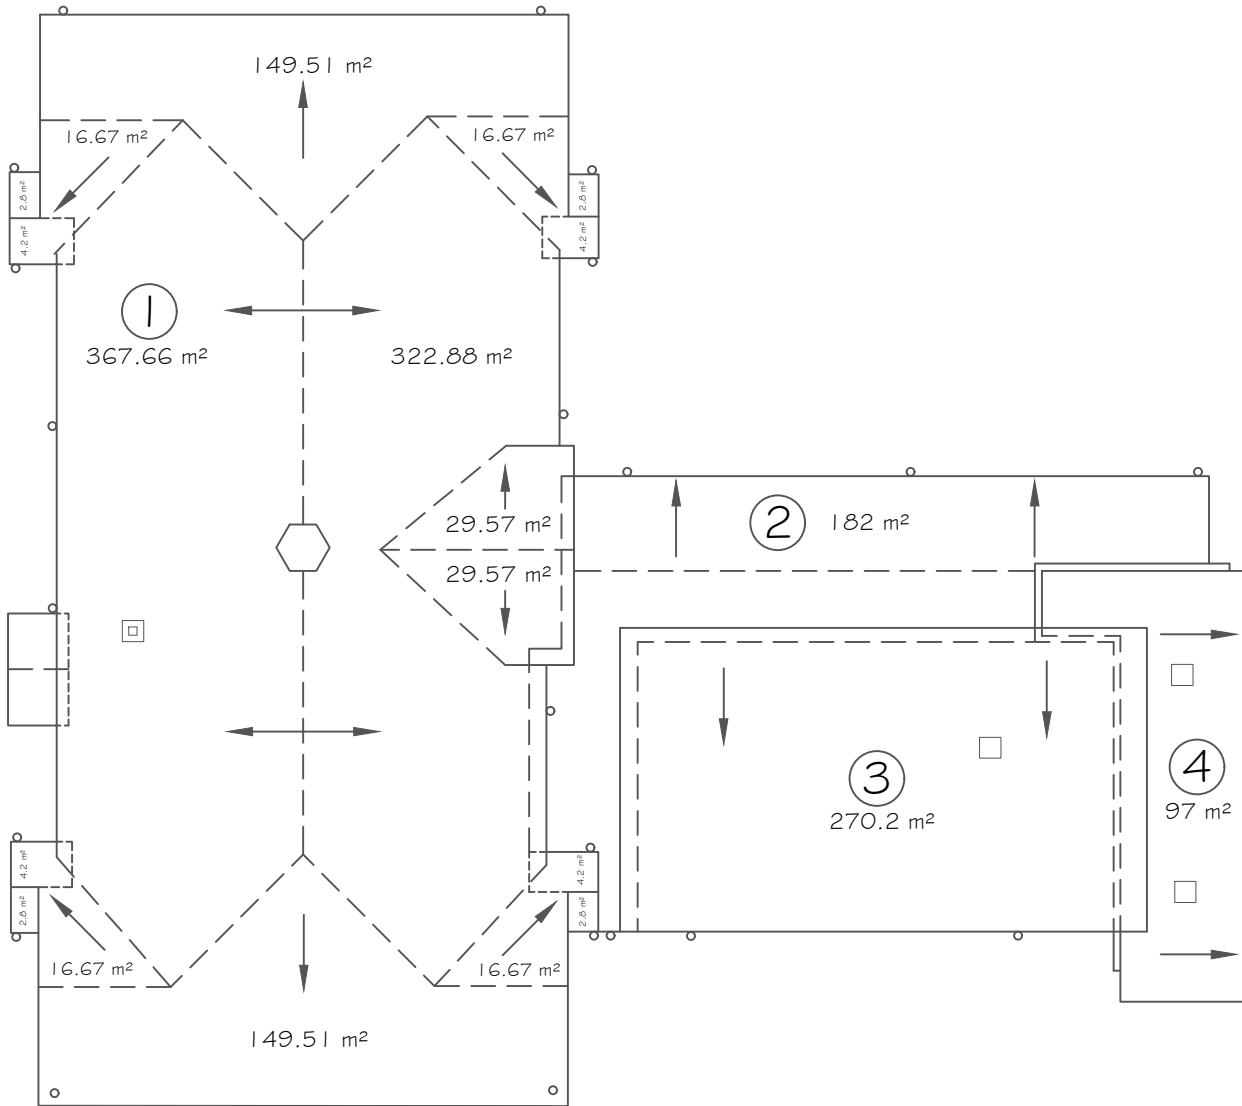

① ROOF PLAN
1:250



ROSSER ELEMENTARY
4375 PANDORA STREET
FACILITIES - RECORD DRAWING
JULY 2020